


T. 2 N., R. 33 E., W.M.

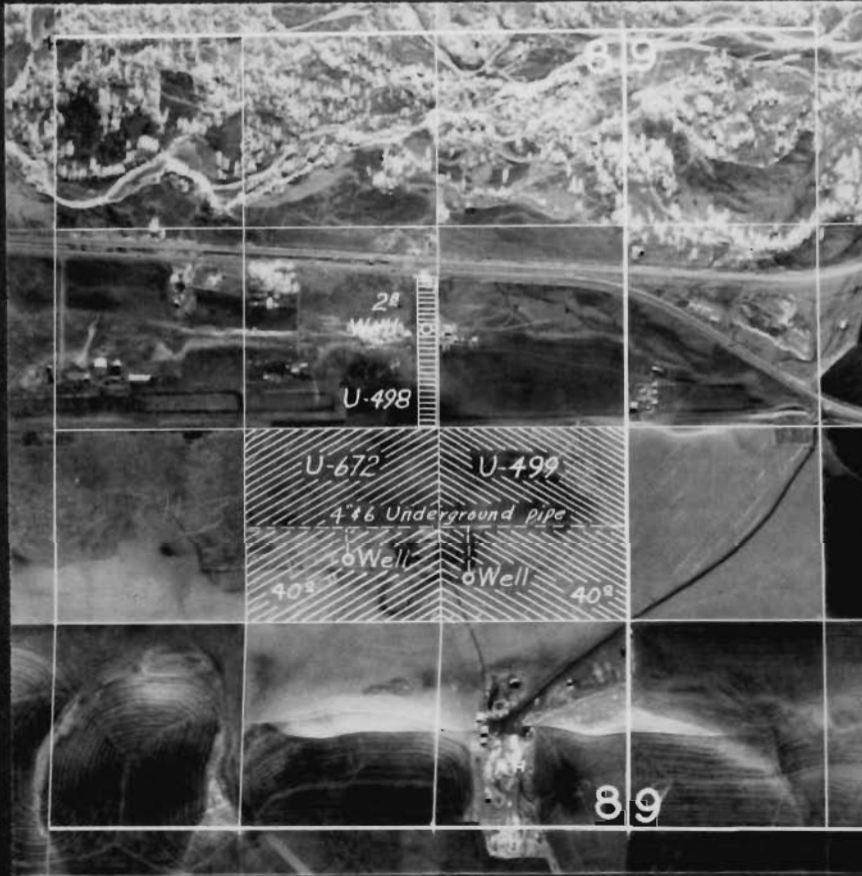

## FINAL PROOF SURVEY

UNDER

Application No. U-498 U-199 U-672 Permit No. U-151 U-155 U-616

IN NAME OF

William Purchase & B. F. Bowman

Surveyed May 14 1954, by T. Jones