


4123
20710

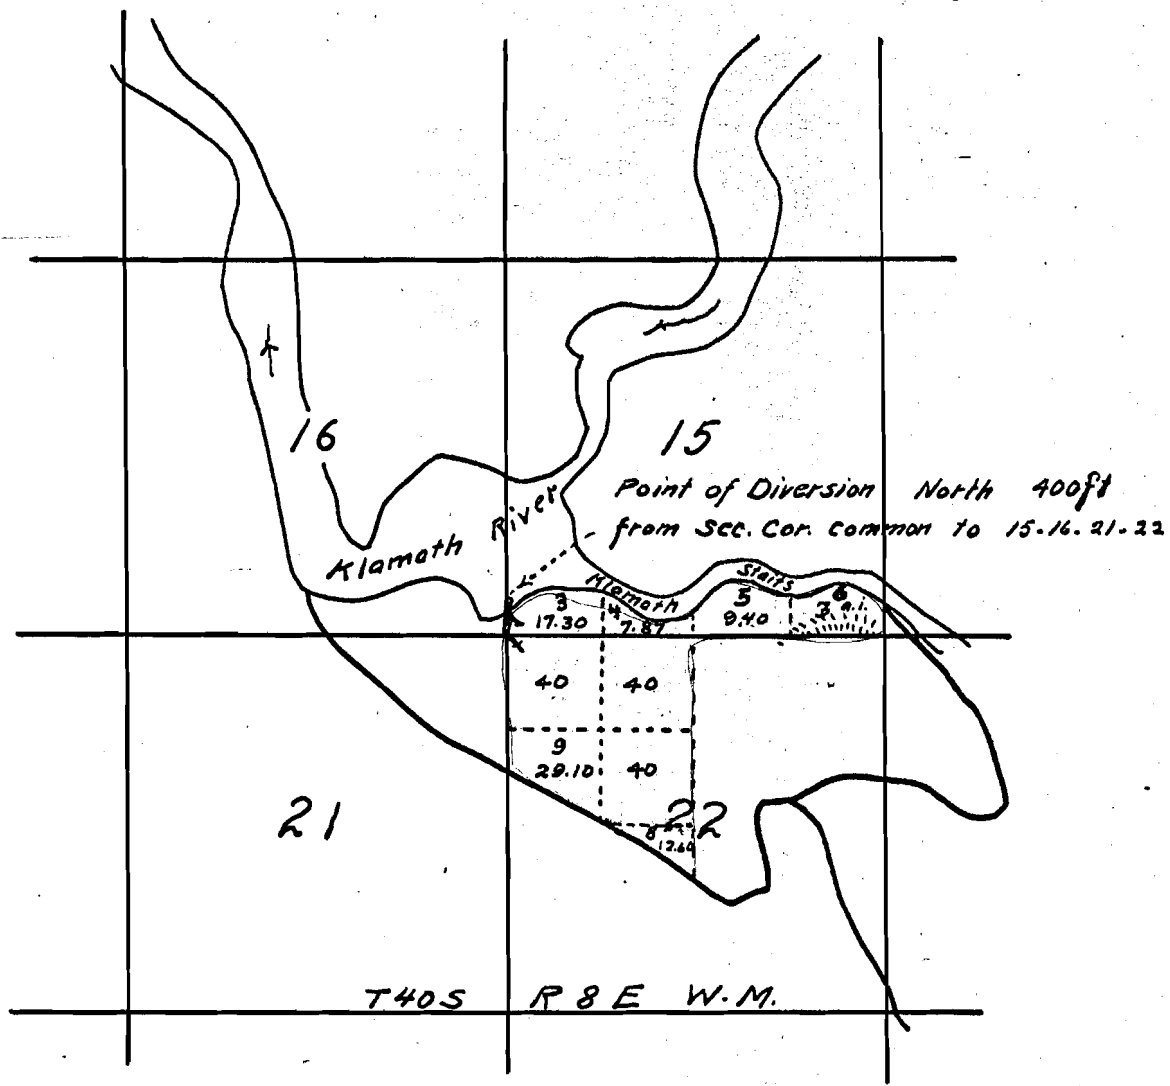

Klamath River

Map
 accompanying application for permit to appropriate
 waters of Klamath River by F.J. Flowers of
 Worden, Ore.

Application No. 6580.
 Permit No. 4123

JUN 1 1900

6580