


T.31S. R.15W. WM

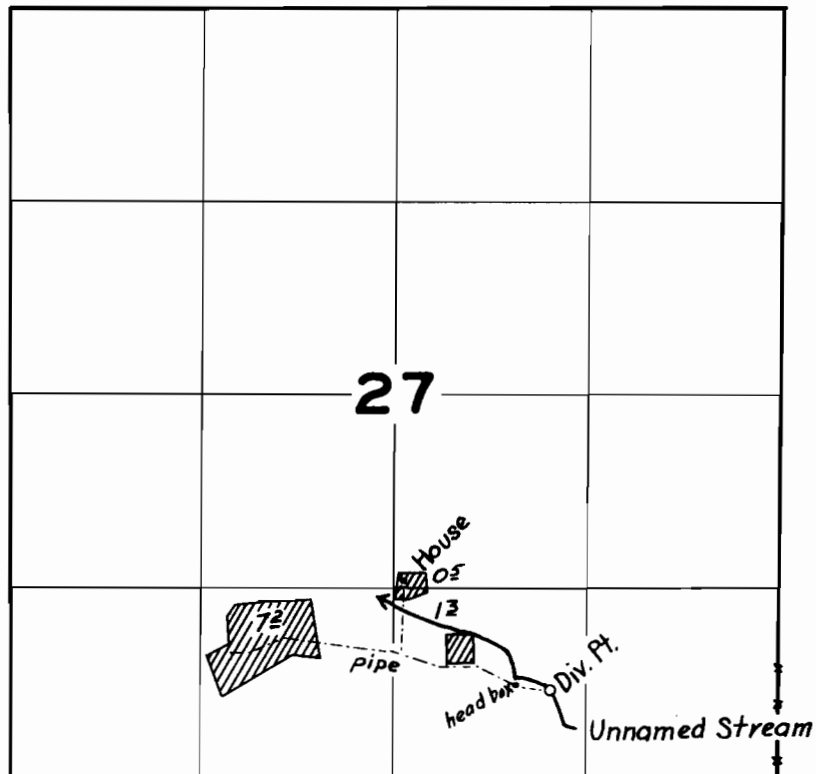

FINAL PROOF SURVEY
UNDER

Application No. 17520..... Permit No. 13225.....
IN NAME OF

Clifford E. Lang

Surveyed Sept 23, 1953., by T. Jones