


T. 18 S., R. 5 W., W.M.

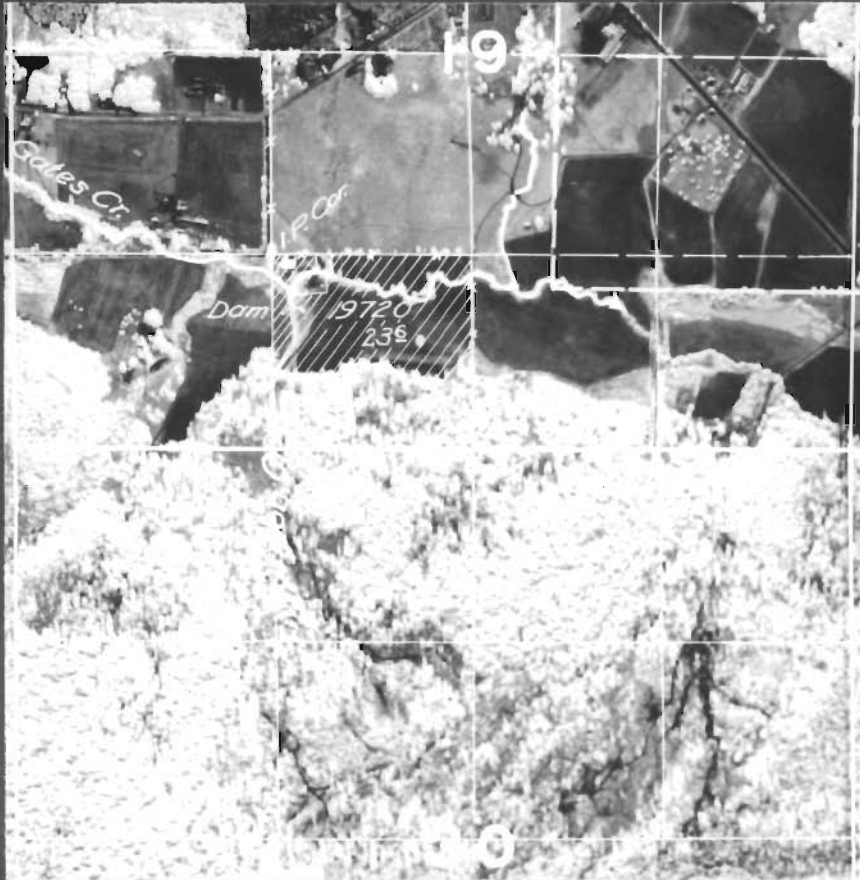

FINAL PROOF SURVEY
UNDER

Application No. 19720 Permit No. 15292
IN NAME OF

R. R. Gibson

Surveyed April 28 19 54, by H. L. Coffman

DBQ-8H-24