


T.17S.R.9W.W.M.

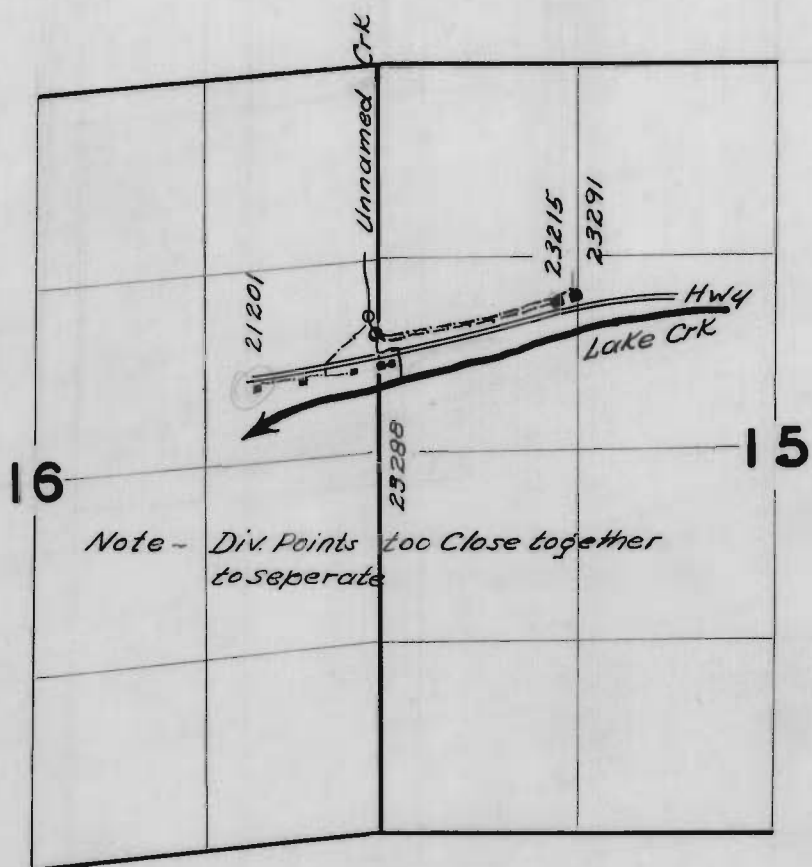

FINAL PROOF SURVEY

Name	Appl. No.	Permit No.
P. J. Feltier	23288	18434
W. H. Weeks & L. B. Weeks	23215	18344
Theodore & Ruth A. Nielsen	21201	16618
Frank Beckley	23291	18374
Surveyed Aug. 12 1954, by H. L. Coffman		