


T.22 S.R.32 1/2 EWM

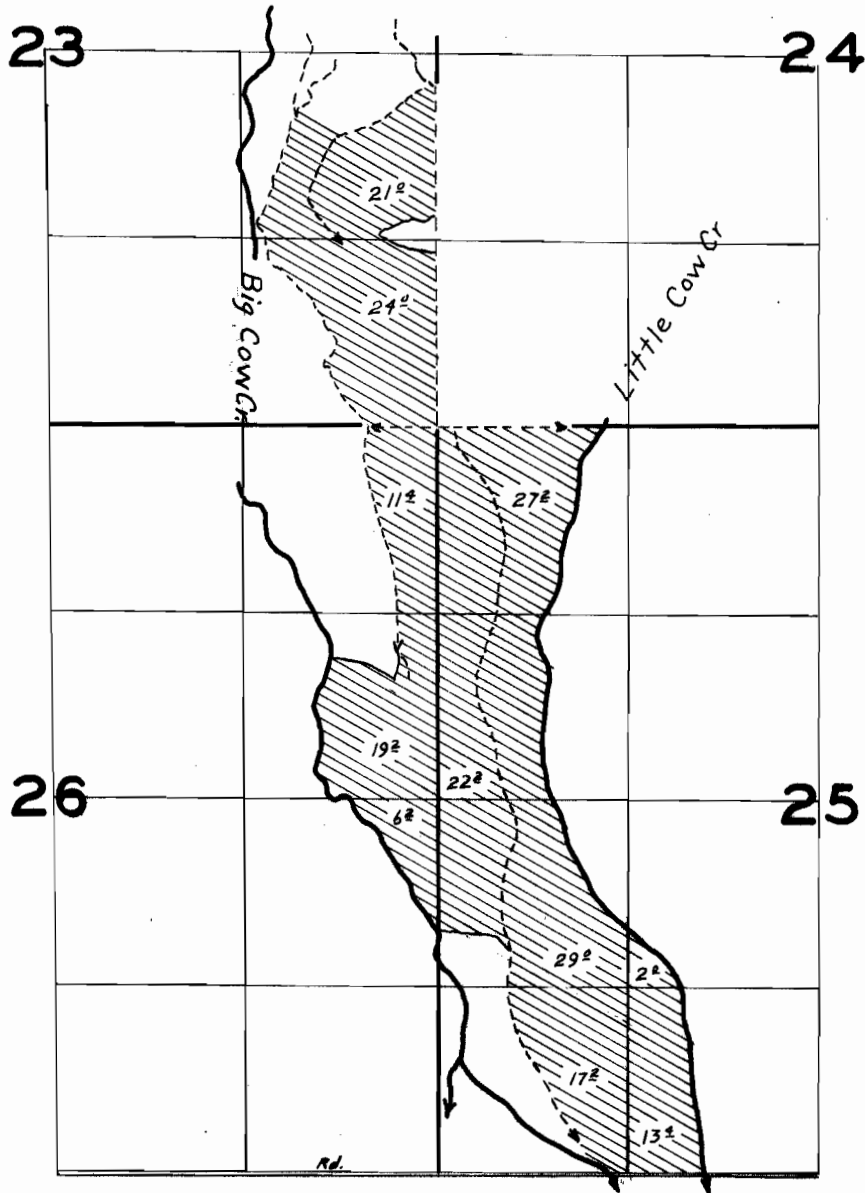

FINAL PROOF SURVEY

UNDER

Application No. 20877..... Permit No. 16351.....

IN NAME OF

.....Frank J. and Viola Smith.....

Surveyed June 25, 1954, by T. Jones.....

HE-10-7

20717