


T.13S.R.1E.W.M.

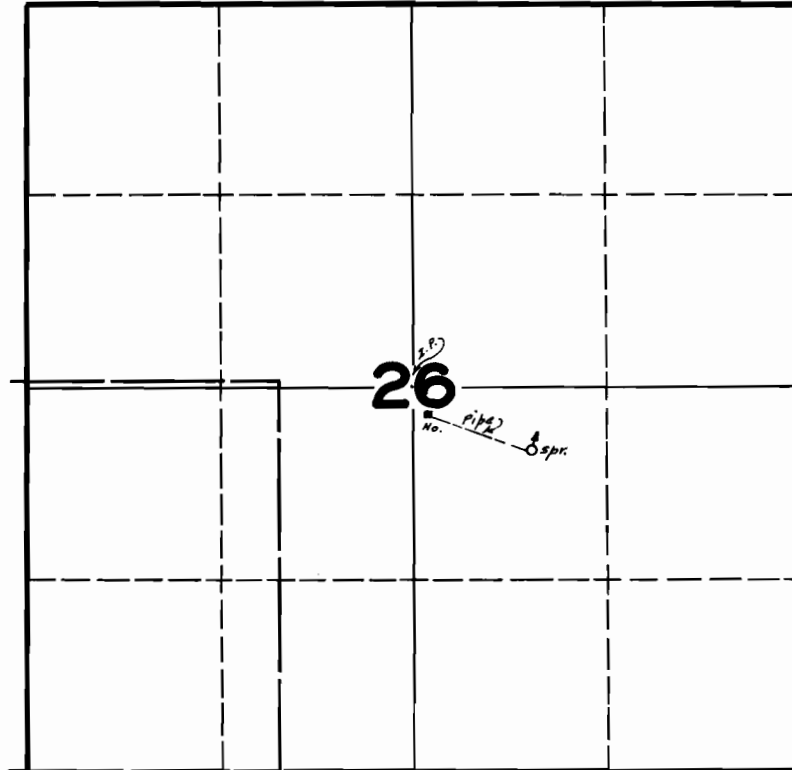

FINAL PROOF SURVEY UNDER

Application No. 21057 Permit No. 16500

IN NAME OF

JAMES R. BROWN

Surveyed JULY 26 1946, by

John L. Cannon