


T. 5 S., R. 1 E., WM.

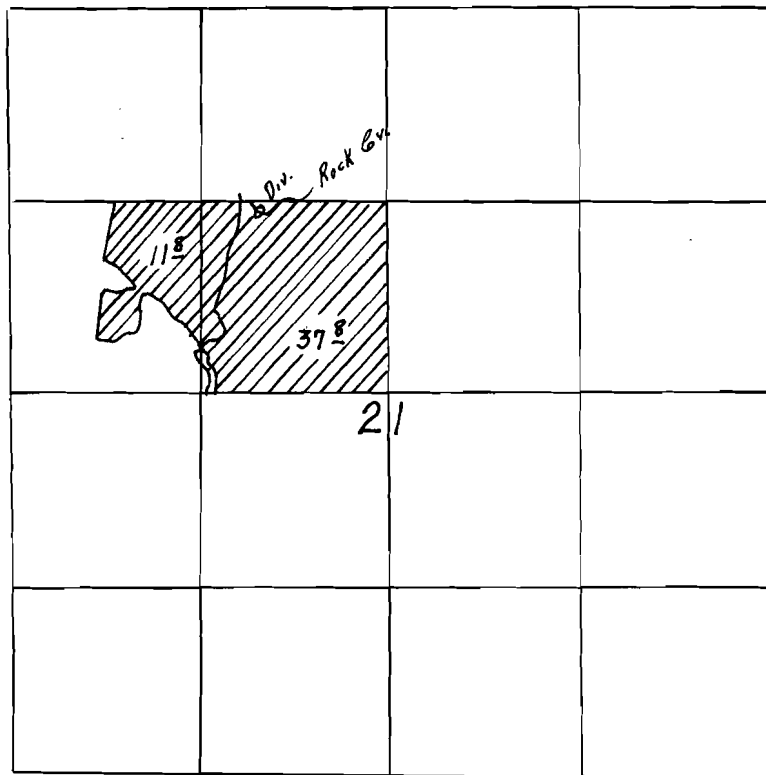

FINAL PROOF SURVEY
UNDER

App No. 21364 Permit No. 17074
IN NAME OF

Albert J. Pirkle


Surveyed July 8 1953 by T. Jones

DFK-3D-43

Capital
LC

21364

T. 5 S., R. 1 E., W.M.

 

FINAL PROOF SURVEY
UNDER

Application No. 21364 Permit No. 1707h
IN NAME OF

ALBERT J. PIRKL

Surveyed July 8 1953 by T. Jones

DFR-2D-43