


T.37 S.R.15 W.W.M.

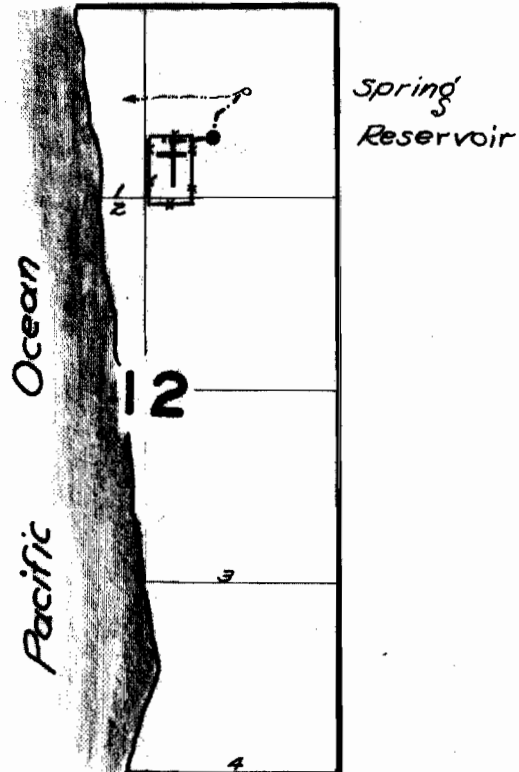

FINAL PROOF SURVEY
UNDER

Application No. 21089 Permit No. 16527

IN NAME OF

Gold Beach Cemetery Association

Surveyed Sept. 16, 1953, by H.L. Coffman