


T. IN. R. 38 E. WM

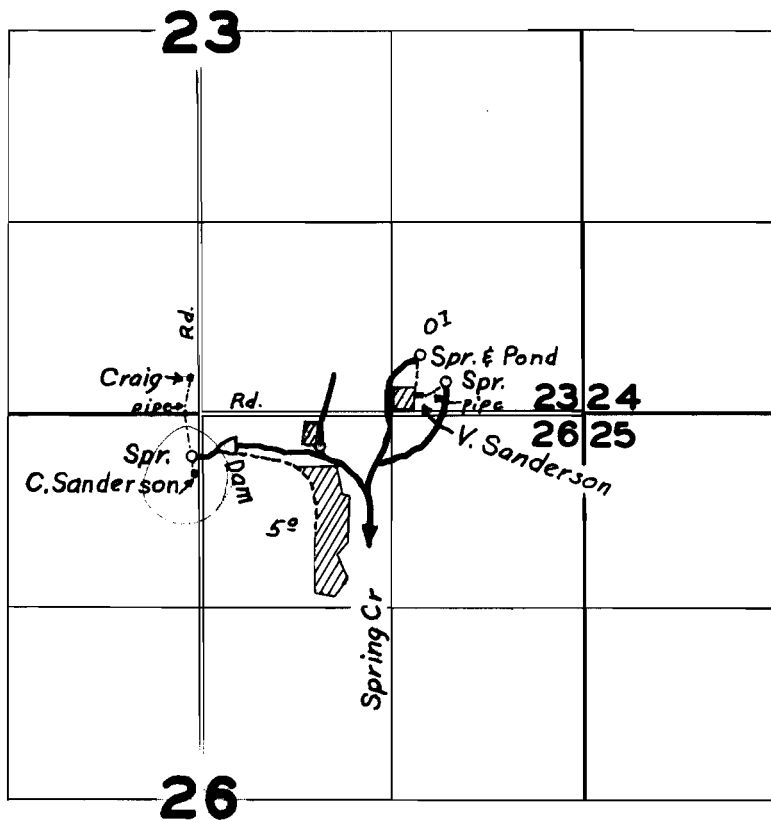

FINAL PROOF SURVEY

UNDER

Application No. 21500..... Permit No. 16863.....

IN NAME OF

D.L. Sanderson, William Sanderson, Charles Sanderson

Surveyed Oct 10 1953, by T. Jones