


T.25S.R.11W.W.M.

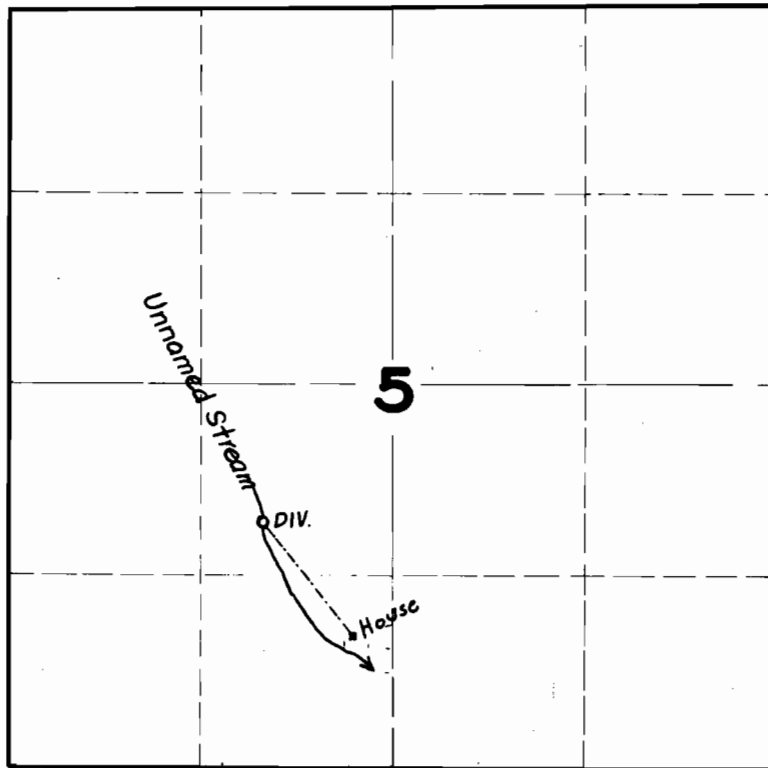

FINAL PROOF SURVEY

UNDER

Application No. **21856**.. Permit No. **17190**....
IN NAME OF

JAMES OTT & FLORENCE OTT....

Surveyed **SER.7**.... **1949**., by **H.L. COFFMAN**..