


T.17S. R.9W.W.M.

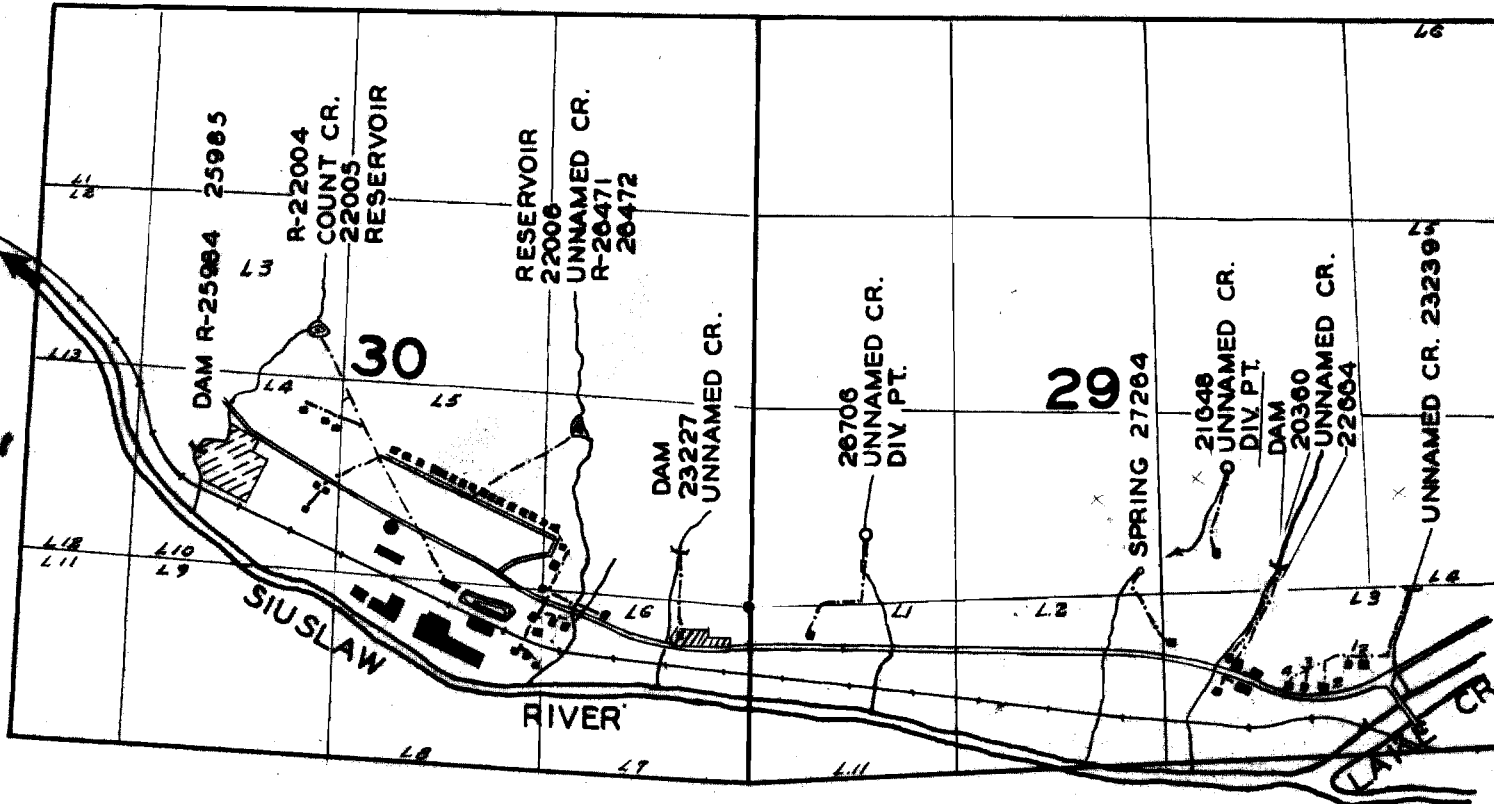

PIPE LOCATION APPROXIMATE

FINAL PROOF SURVEY
UNDER

Name	Appl. No.	Permit No.
The Consumers Cooperative Assoc.	22006 ✓	17323
The Consumers Cooperative Assoc.	26472	20750
The Consumers Cooperative Assoc.	R-26471	R-1257
The Consumers Cooperative Assoc.	R-22004 ✓	R-853
The Consumers Cooperative Assoc.	22005	17322
The Consumers Cooperative Assoc.	22006 ✓	17323
Western American Lumber Co.	25985	20361
Western American Lumber Co.	R-25984	R-1170
Sam Haywood Lynch	20360	15882
Christopher C. Poissot	21648	17082
Walter H. Beers	27264	21447
Herman B. Holcomb	26706	20905
John N. Seaver & Sons & C. M. Lane	22664	17804
Byrd L. Tompkins	23227 ✓	18288
J. Mann, G. Brockman, L.L. Frazier, & C.E. Elder	23239	18304

Surveyed August 10, 11, 12 1954 by H. L. Coffman DBQ-17H-121

Note - Keep this tracing in folder 27264