


T.7N.R.2W.W.M.

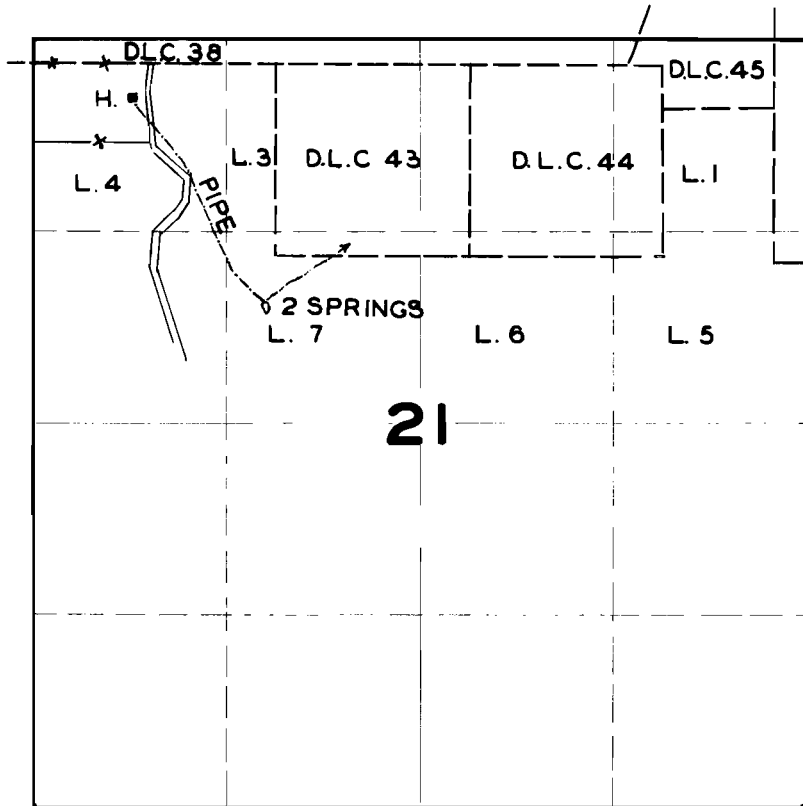

FINAL PROOF SURVEY

UNDER

Application No. 21773 ... Permit No. 17069
IN NAME OF

FLORENCE P. PRICHARD

Surveyed AUG. 1. 1950., by H.L. COFFMAN