


T.6S.R.4W.WM

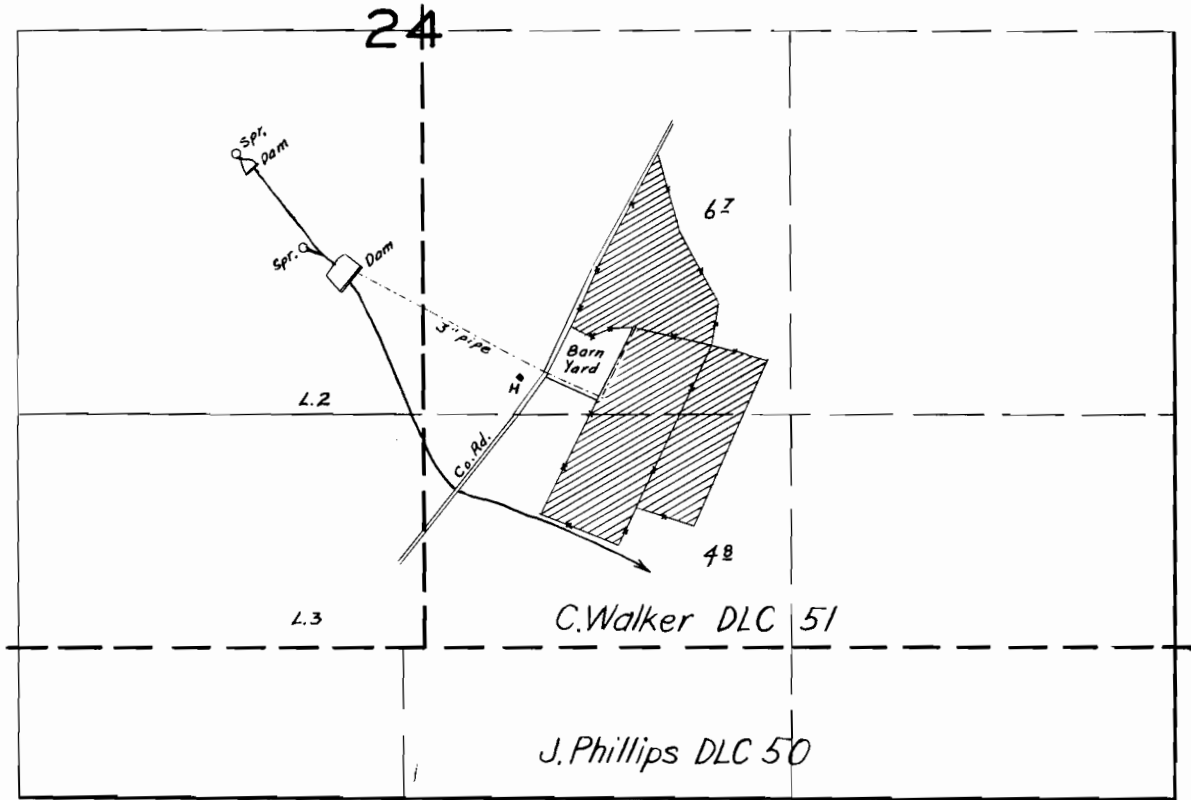

Scale 1"=660'

FINAL PROOF SURVEY

UNDER

Application No 22026 Permit No. 17306.....

IN NAME OF

Byron J. Purvine

Surveyed March 2, 1955, by T. Jones