


T.40S. R.13W WM

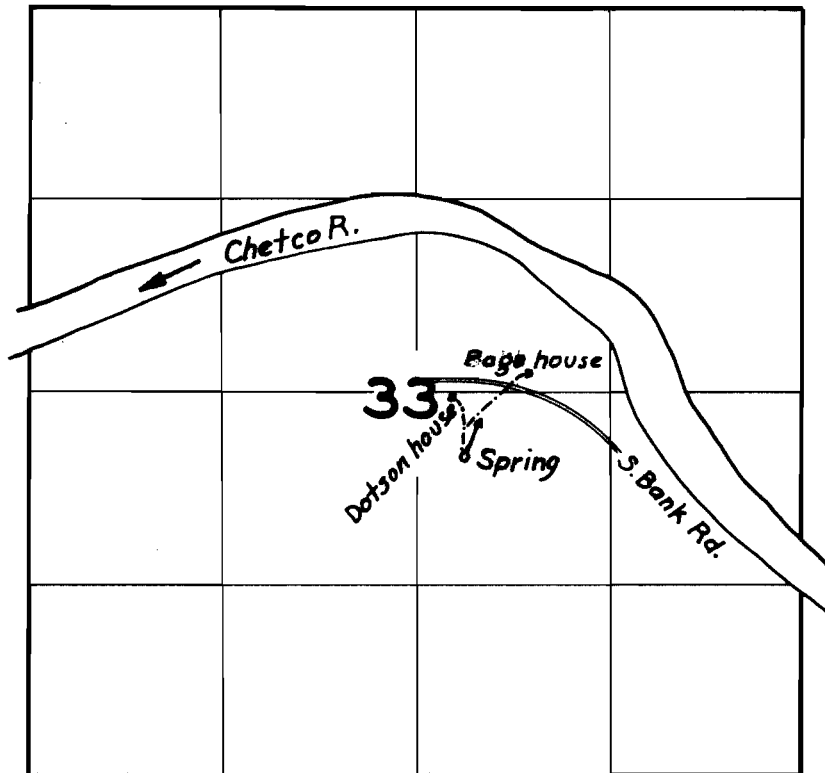

FINAL PROOF SURVEY UNDER

Application No. 22926..... Permit No. 18072.....

IN NAME OF

Bradley Page & Olive M. Page

Samuel & Hannah B. Dotson

Surveyed Sept 18 1953, by T. Jones.....

1953-Y