


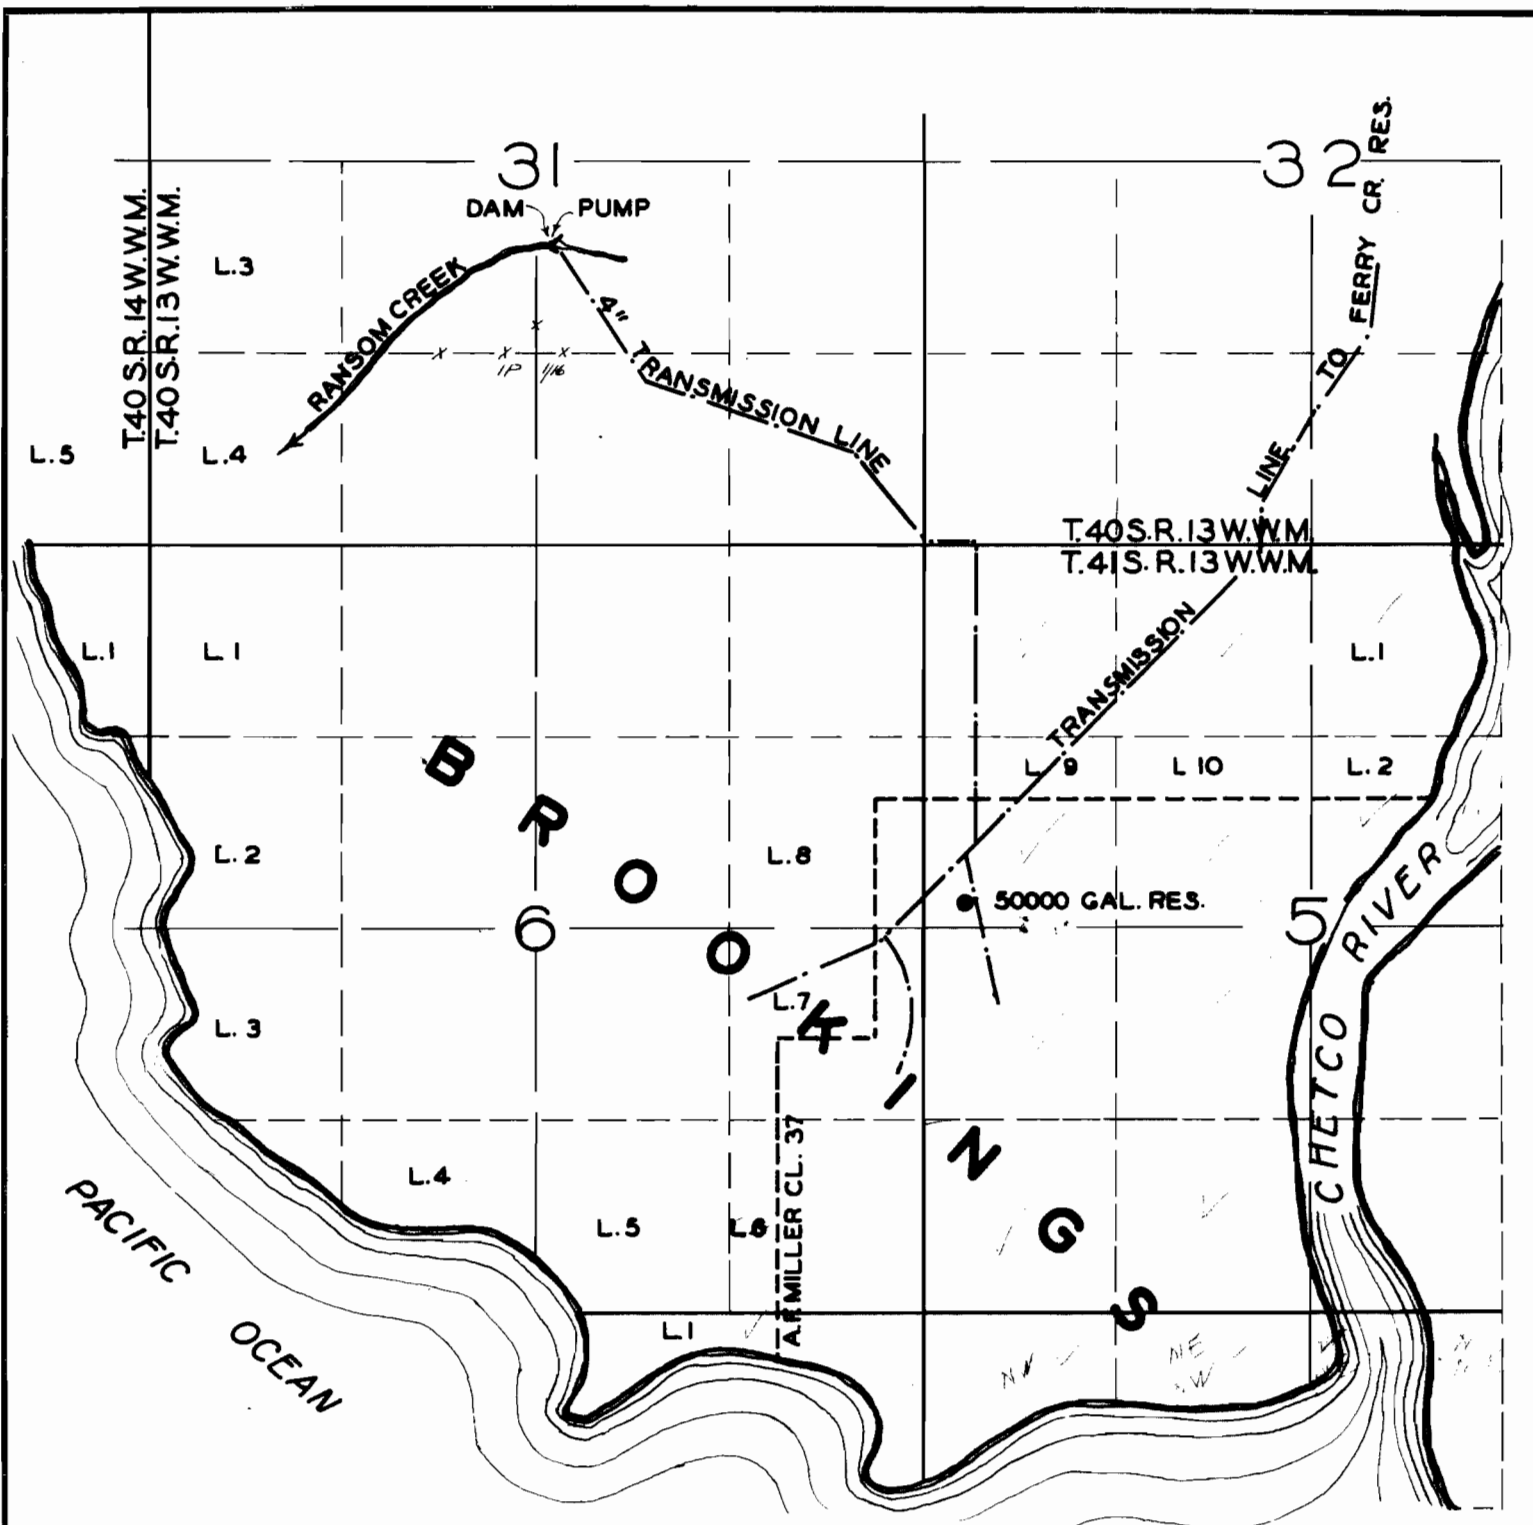

FINAL PROOF SURVEY UNDER

Application No. **22928** Permit No. **18123**
IN NAME OF

ELMER BANKUS FOR BROOKINGS WATER CO.

Surveyed **AUG. 11, 1949**, by **H.L. COFFMAN.**