


T.6S.R.1&2E.WM

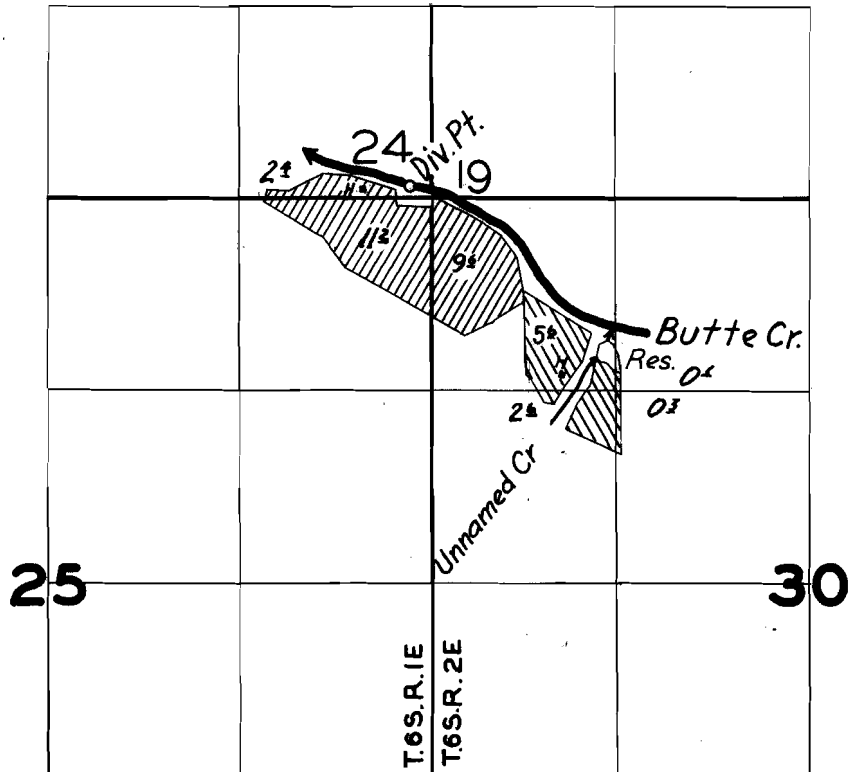

22937
21865

FINAL PROOF SURVEY

R-22936

R-925

22937

18124

Application No. 21865 Permit No. 17197

IN NAME OF

C. B. Haroldson

Mildred E. Caster

Surveyed Jan 26 1954, by A. Jones

SECTION

TOWNSHIP 6S, RANGE 2E, W. M.

North

West

East

South

R 22936

22937

2-385

APPLICATION No.

PERMIT No.