


SECTION

TOWNSHIP _____, RANGE _____, W. M.


North

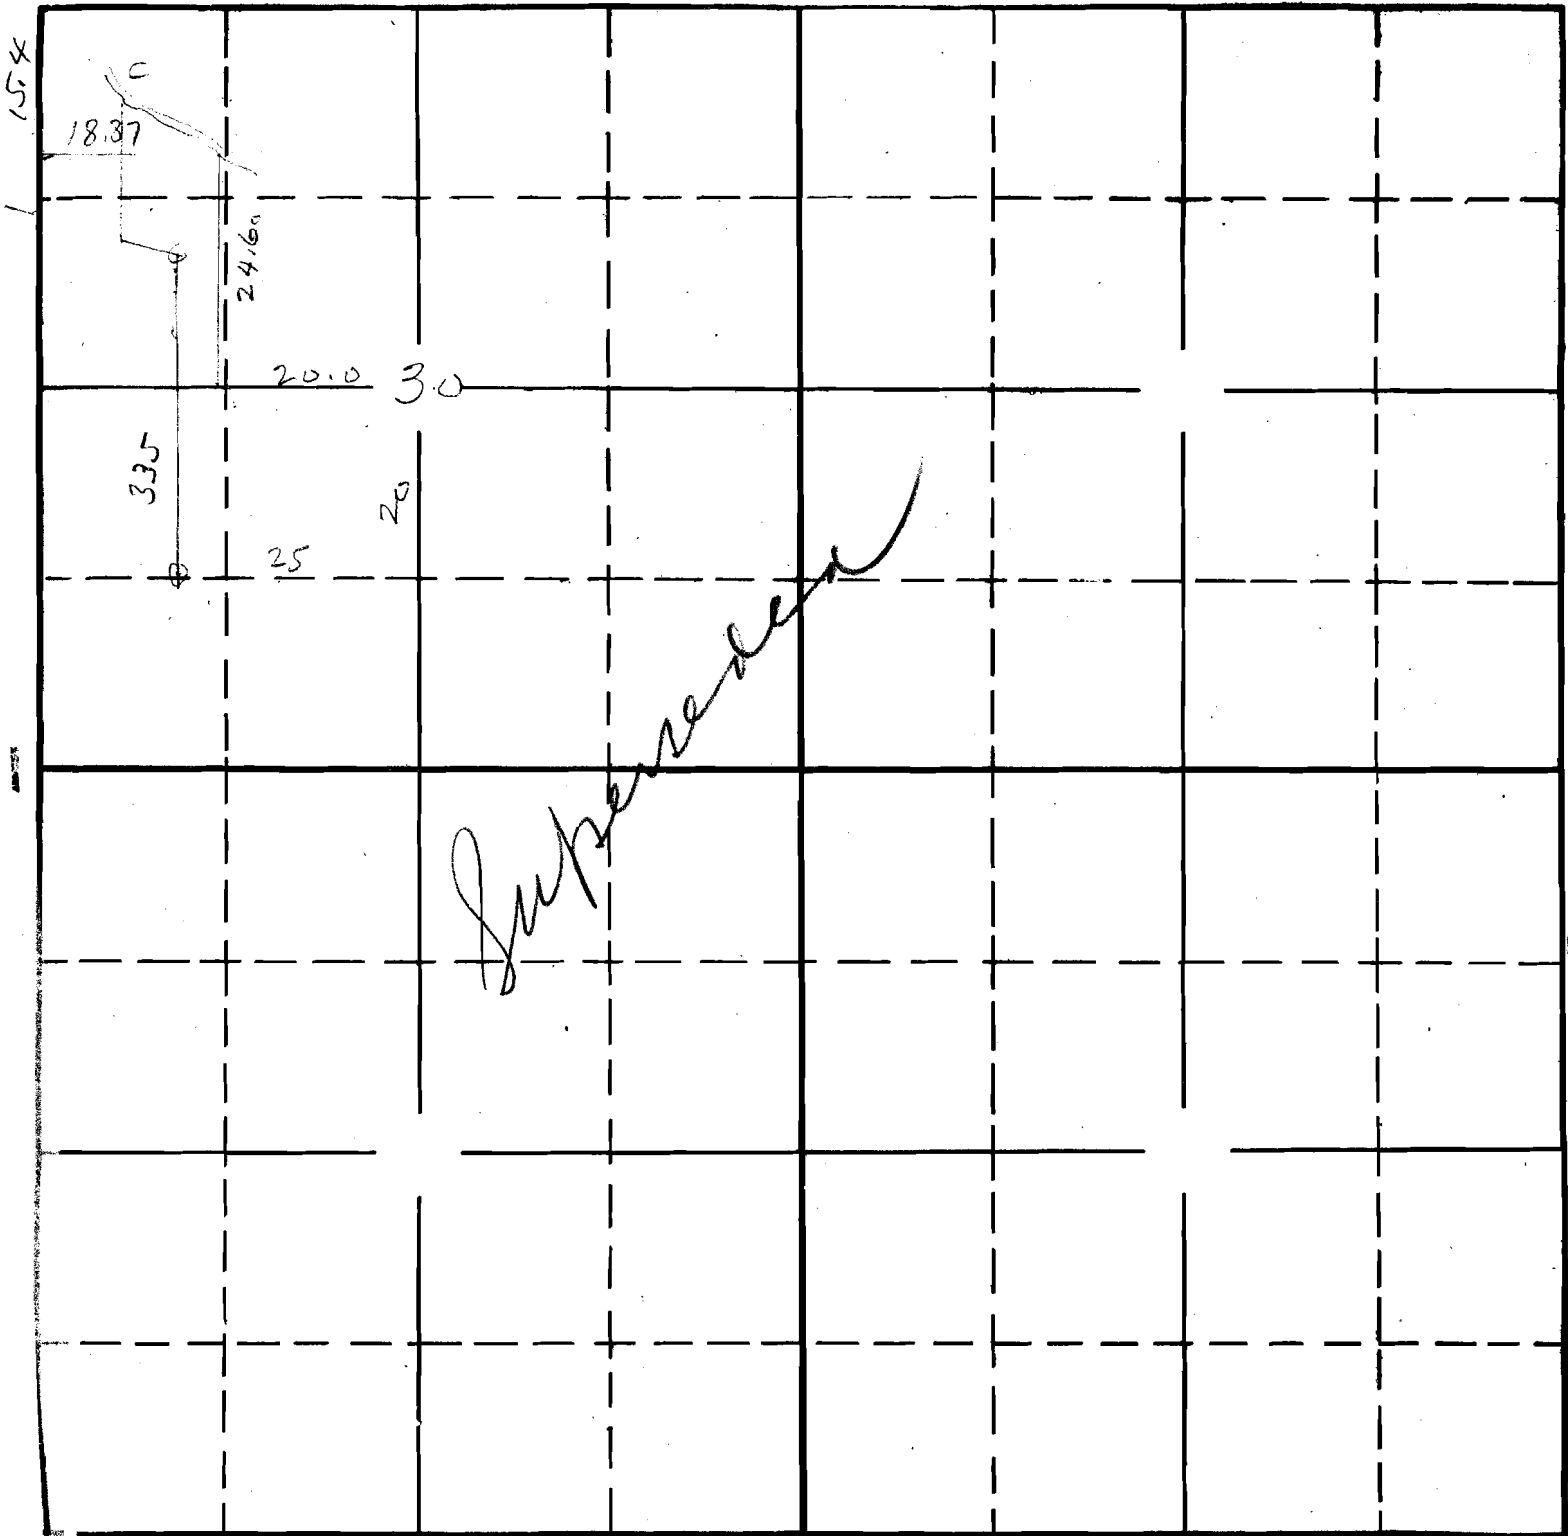

South

APPLICATION No.
PERMIT No.

T.6S.R.1&2E.WM

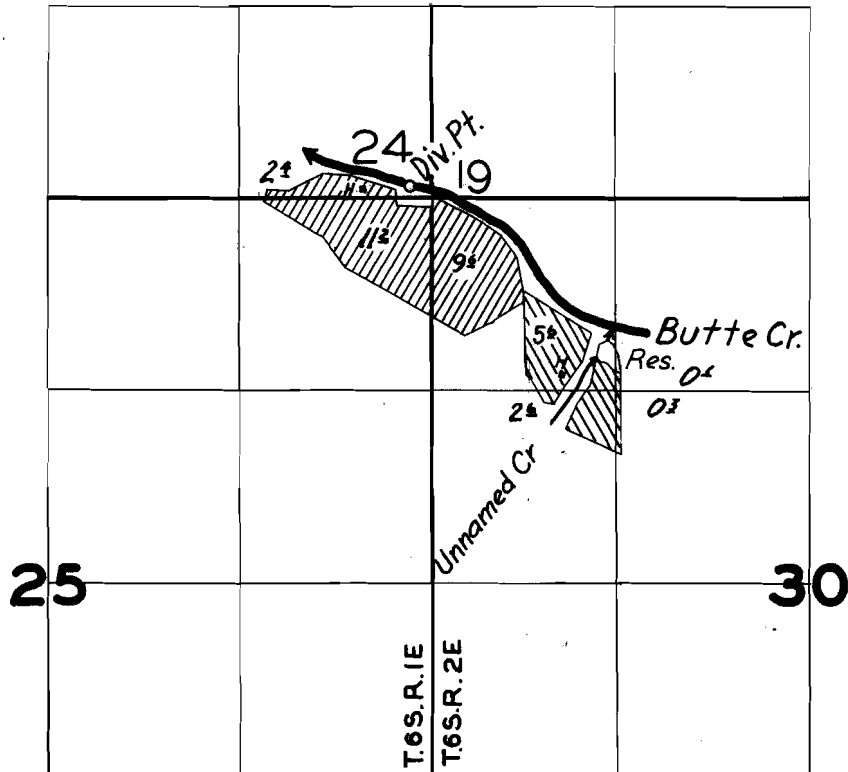

 22937
 21865

FINAL PROOF SURVEY

R-22936

R-925

22937

18124

Application No. 21865 Permit No. 17197

IN NAME OF

C. B. Haroldson

Eldred E. Caster

Surveyed Jan 26 1954, by A. Jones