


T. 2 S., R. 3 E., W.M.

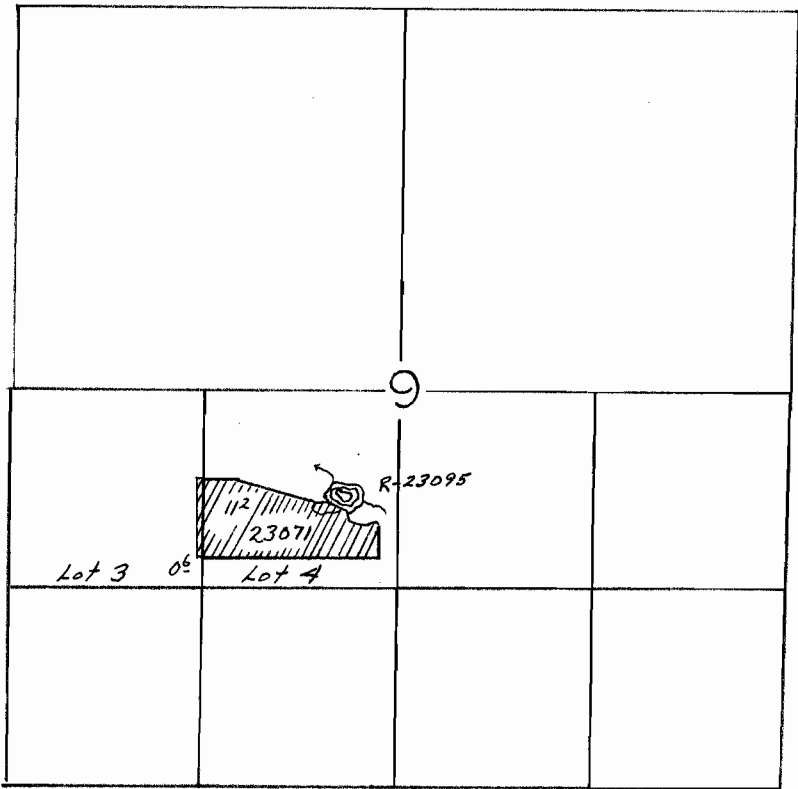

# FINAL PROOF SURVEY

UNDER

R-23095

R-932

Application No. 23071 Permit No. 18207

IN NAME OF

CARL STAATS

Surveyed June 25 1953 by H. L. Coffman