


T. 7S. R. 5W. WM

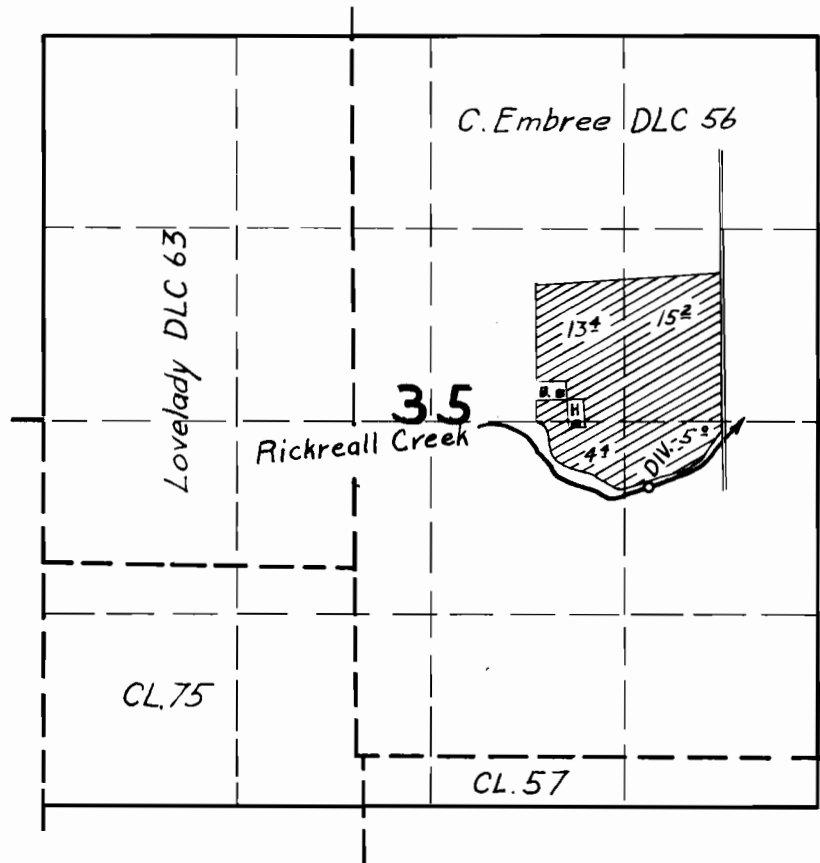

FINAL PROOF SURVEY

UNDER

Application No. 23608 ... Permit No. 18872 ...

IN NAME OF

Pete Brandt

Surveyed Aug. 5 19 54, by T. Jonas

DFP-2D-164