


T. 28 S., R. 6 W., W. M.

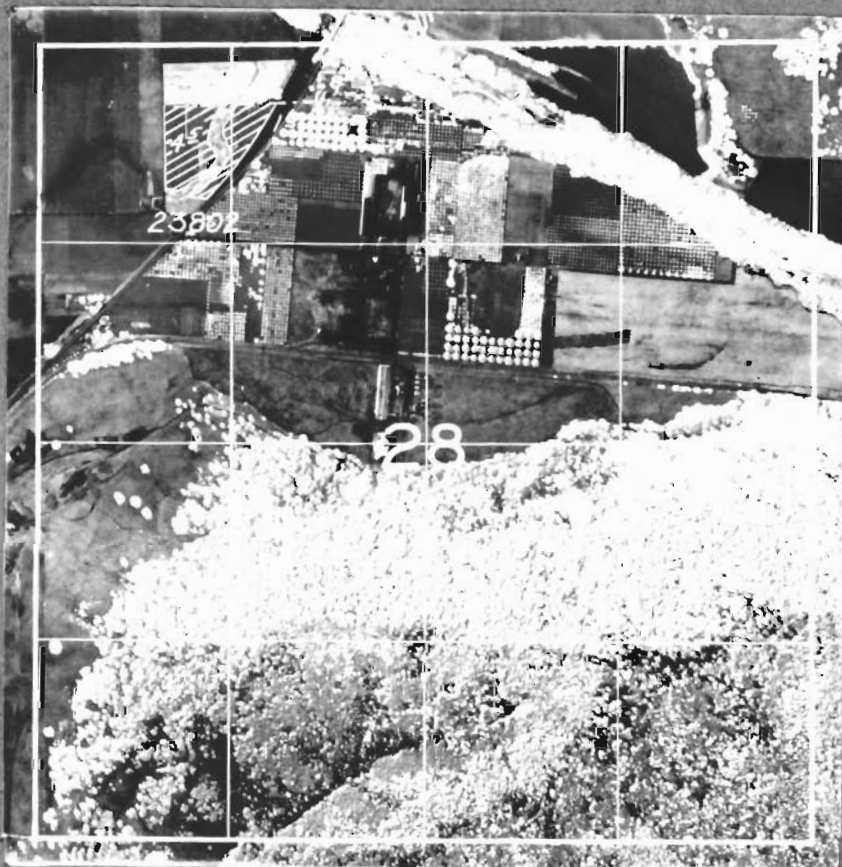

FINAL PROOF SURVEY
UNDER

Application No. 23802 Permit No. 18818
IN NAME OF

C. E. MOYER

Surveyed May 12 1953, by H. L. Coffman

DB-HW-18-69