


# T. 27S. R. 3W. WM

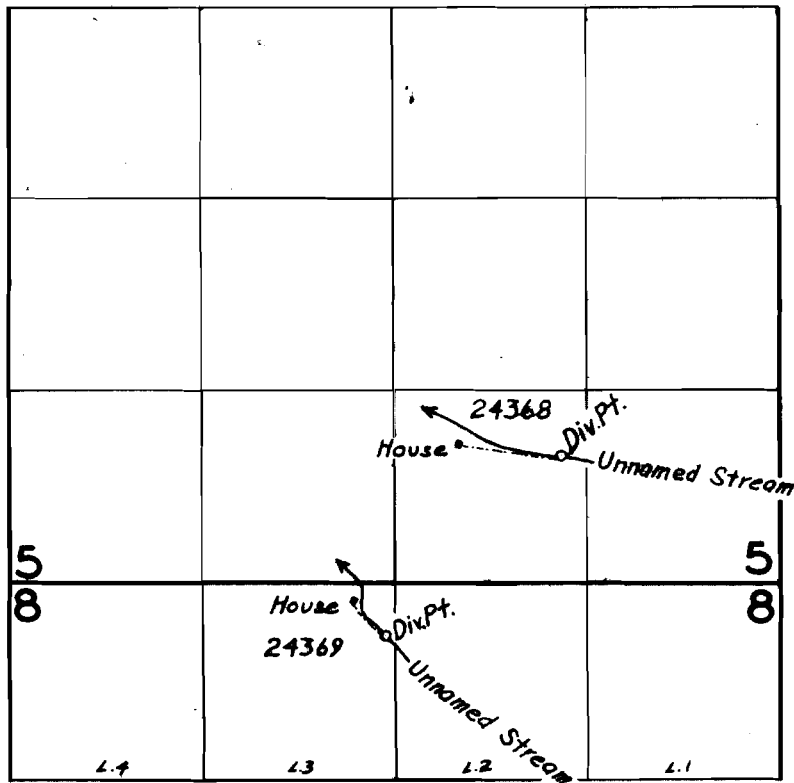

## FINAL PROOF SURVEY

UNDER

Application No. 24369..... 19451  
Application No. 24368..... Permit No. 19450.....

IN NAME OF

..... Fred C. and Paula Heinz .....

Surveyed July 25 1951, by T. Jones.....

1954-z