


MAP NUMBER ~~20~~ P. 20421  
APP. NO. 26162  
PER. NO. ~~20421~~ 20421  
PRIORITY DATE 7/9/51  
STREAM Aggregate Misc.

T. 40 S., R. 3 W., W. M.

CERT- 20750

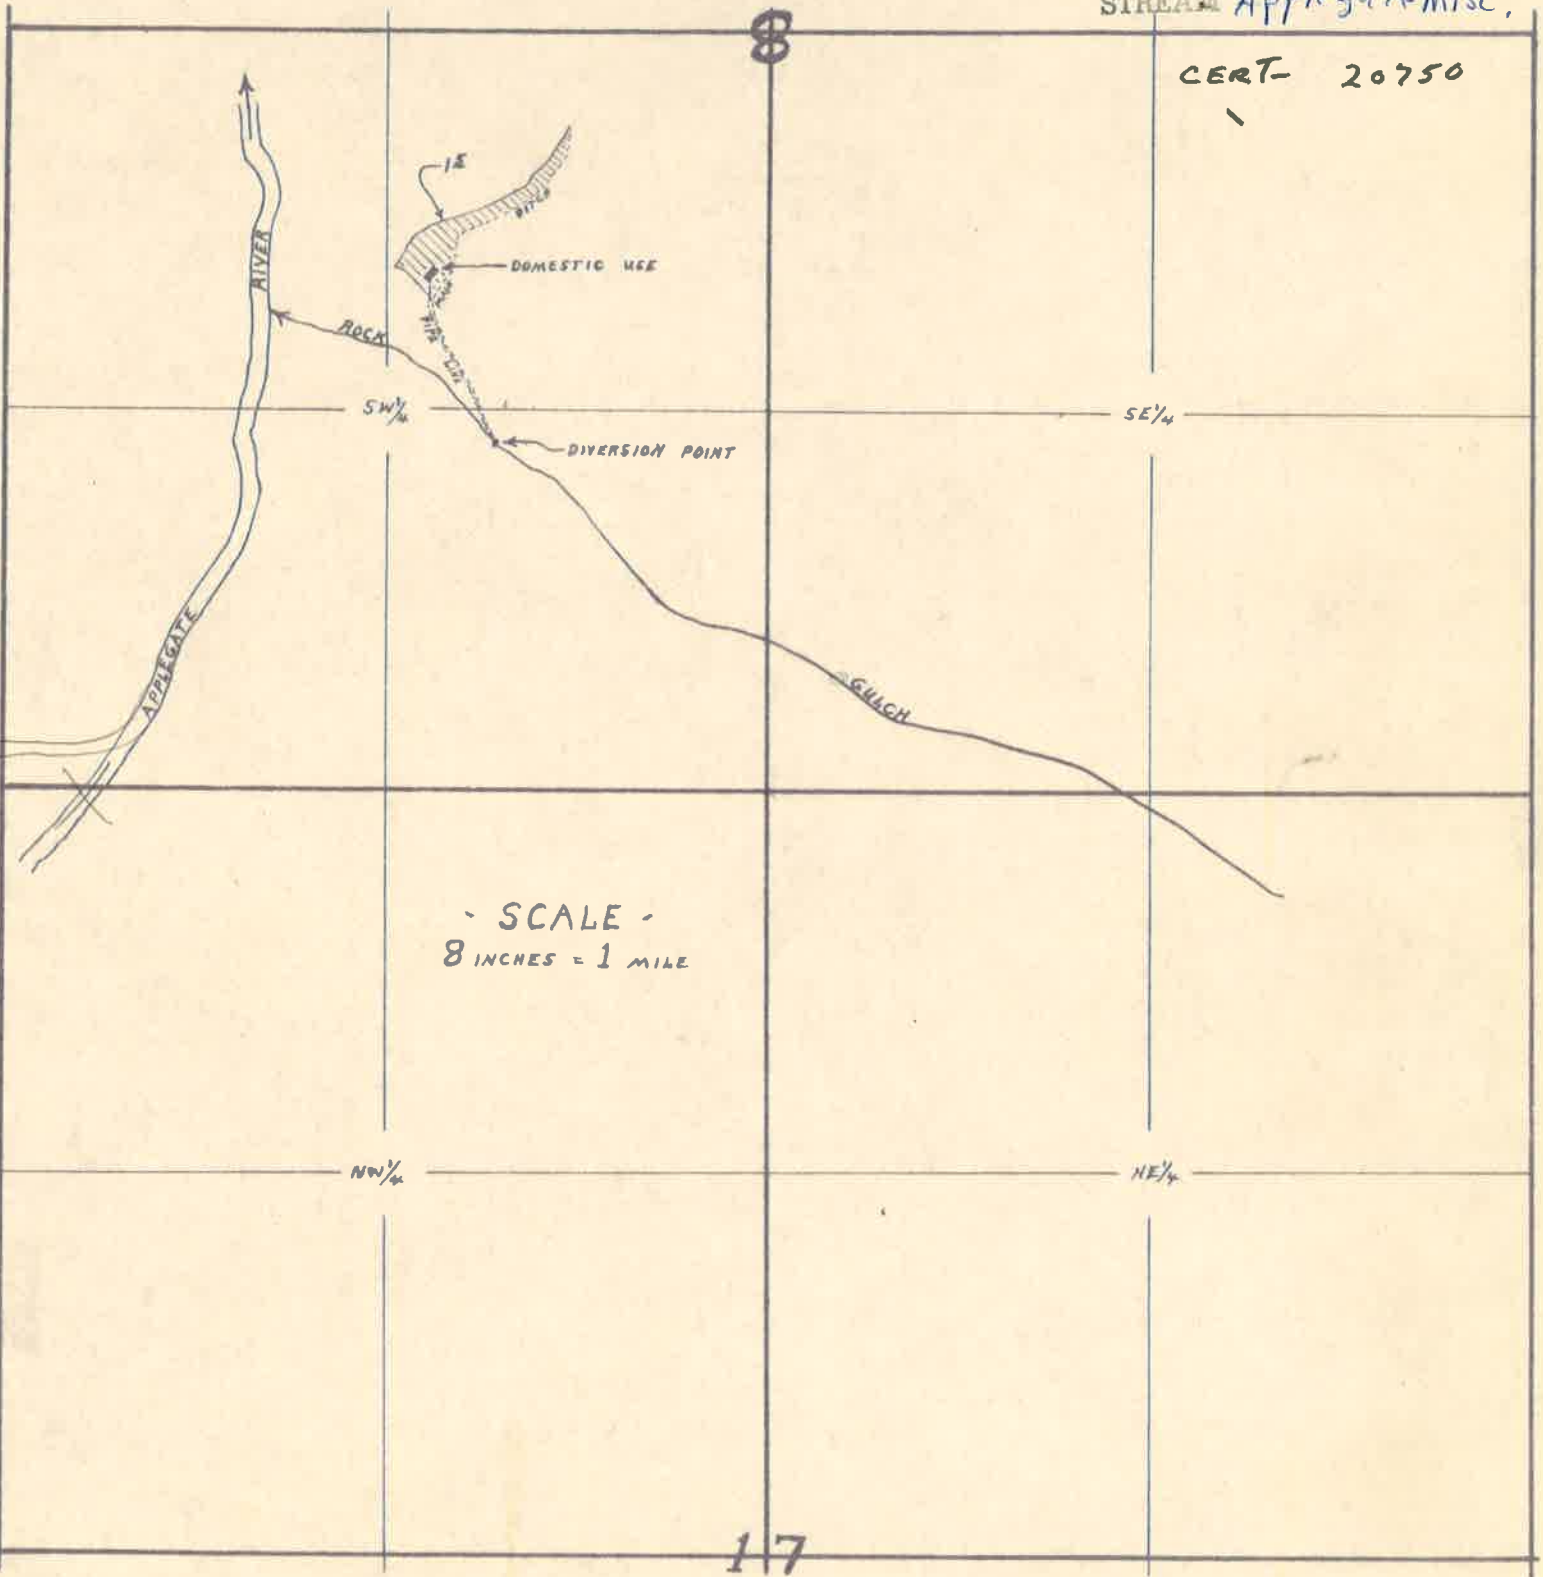

MAP ACCOMPANYING FINAL PROOF OF MORRIS BYRNE, FOR USE OF WATER FROM ROCK GULCH FOR DOMESTIC AND IRRIGATION PURPOSES.

APPLICATION No. 26162  
PERMIT No. 20421

MAP COPIED FROM PLANE TABLE SURVEY - MADE 9-29-54

David L. Hendrick  
WATERMASTER DIST. #15