


Map accompanying final proof of John L. Nealon, for use of water from Rogue River, Drain Ditch No. 1, Drain Ditch No. 2 and Slough for irrigation purposes. 2/10 4/15/55

Application No. 26999

Permit No. 21410

David C. Hendrix, Watermaster Dist. No. 15

SECTIONS 10, 11, 14, & 15; T. 36 S.; R. 2 W., W.M.

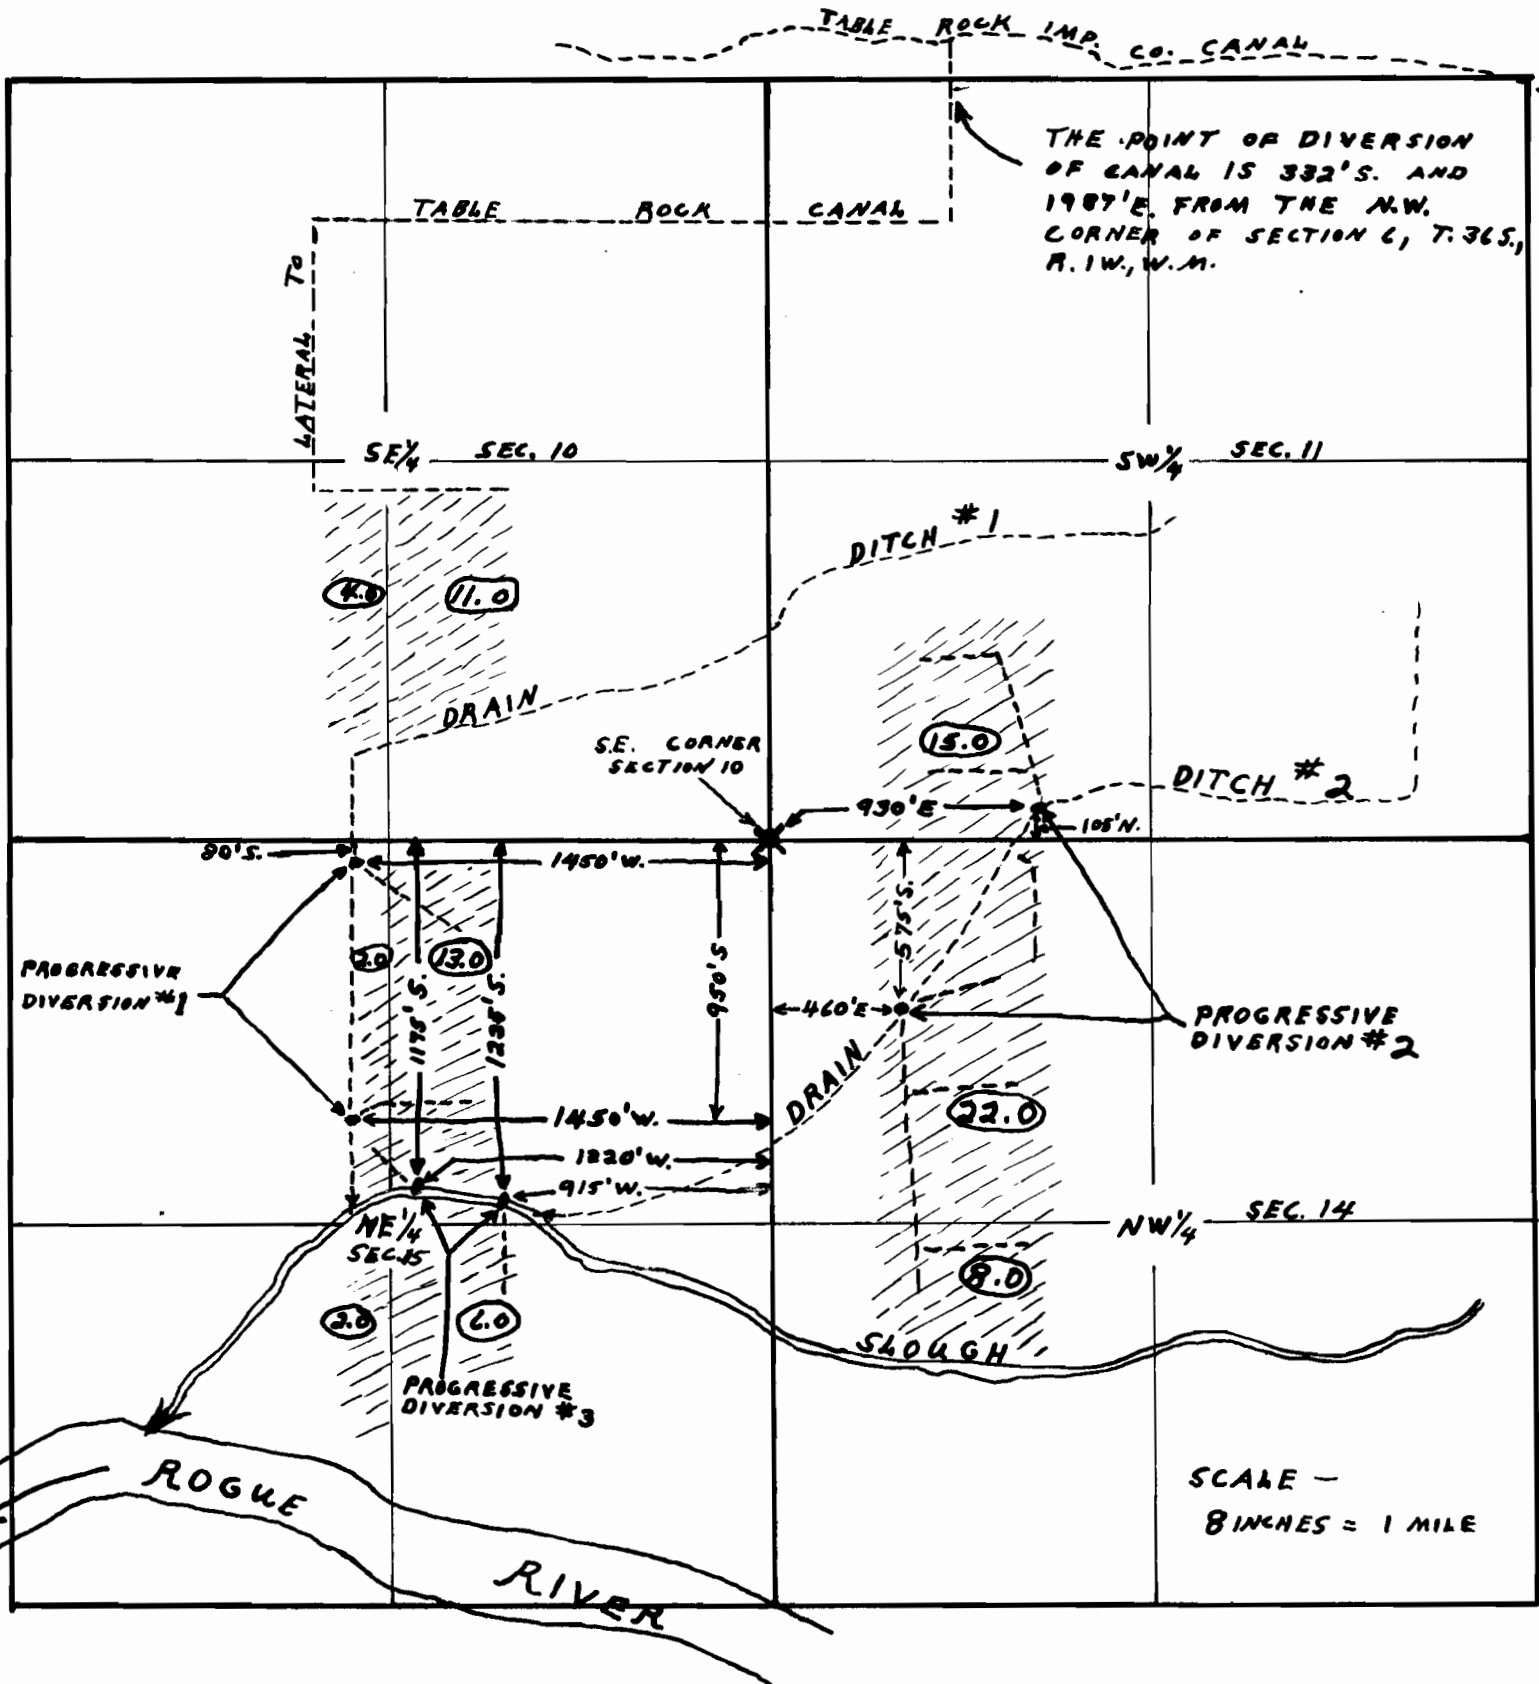

MAP TO ACCOMPANY APPLICATION OF JOHN L. NEALON FOR USE OF WATER FROM ROGUE RIVER, #1 DRAIN DITCH, #2 DRAIN DITCH, AND SLOUGH FOR IRRIGATION PURPOSES.

RECEIVED
 MAR 20 1952
 STATE ENGINEER
 SALEM, OREGON

THIS OFFICE 3-18-52
 D. L. Hendrix
 Applied No. 26999
 Permit No. 21410