


T. 39 S., R. 3 W., W.M.

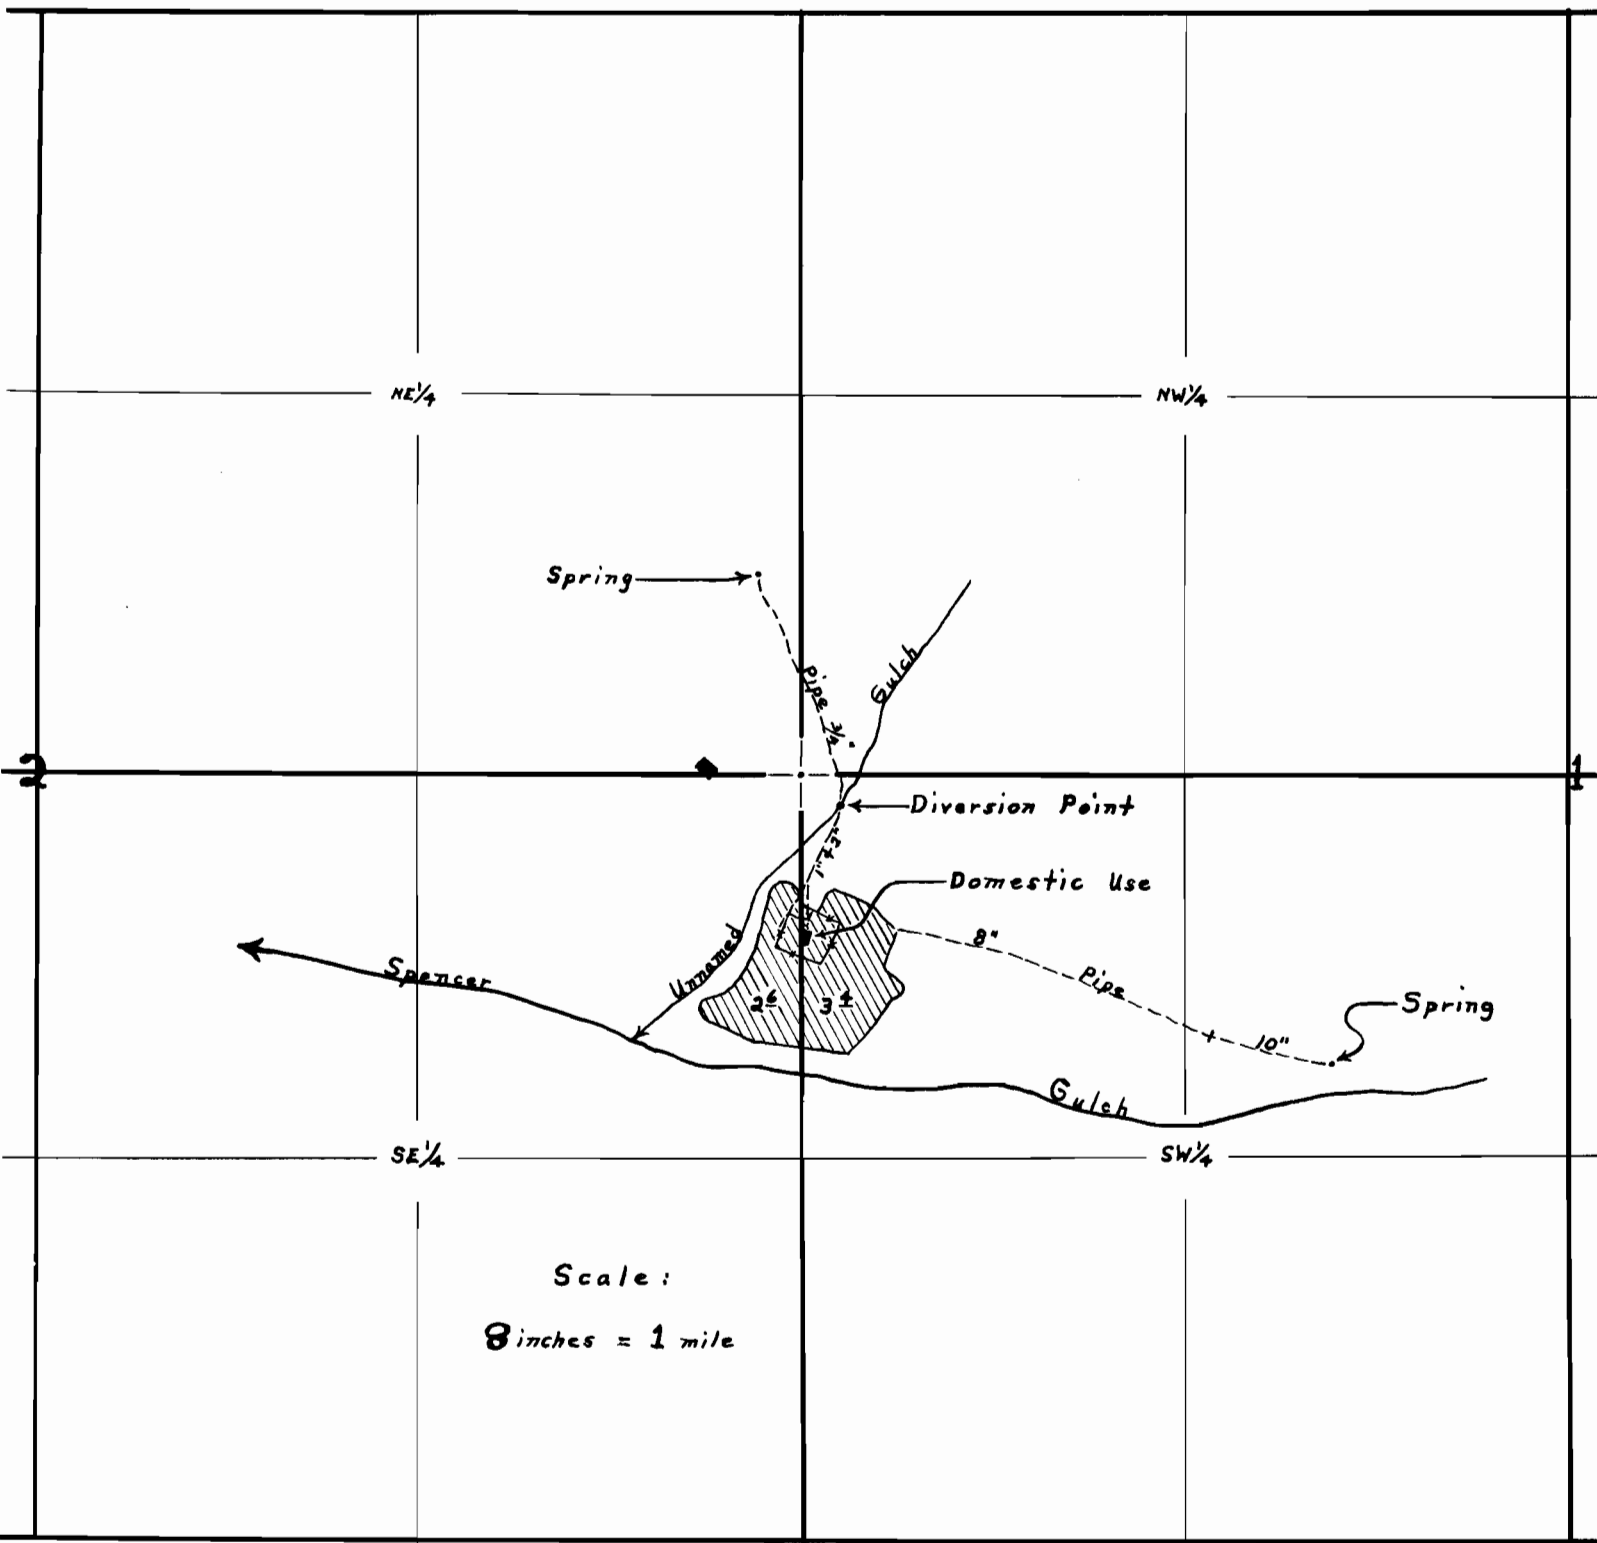

Scale:  
8 inches = 1 mile

Map accompanying final proof of Chester R. Pursell, for use of water from unnamed gulch and two springs for Domestic use and Irrigation purposes.

Application No. 20384  
Permit No. 15897

Plane table survey, made 3-4-55

David C. Hendrix, Watermaster Dist. No. 15