


Note - Help this financing in older 27264

The Consumers Cooperative Assoc.	17323	22006	26472	R-26471	R-1257	B-853	22005	17322	17323	22006	R-1170	R-25984	25985	20361	25985	20361	R-1170	Sam Haywood Lynch	Chritisstopher C. Poisot	Walter H. Beers	Hermann B. Holcomb	John N. Sawyer & Sons & Co., H.	Dillard L. Tompkins	J. Mann, G. Brockman, L. L. Frazier, & C. E. Elder	Surveyed August 16, 11, 12 1954 by H. L. Coffman DPG-17H-121

Name Appl. No. Permit No.

FINAL PROOF SURVEY

RPE LOCATION APPROXIMATE

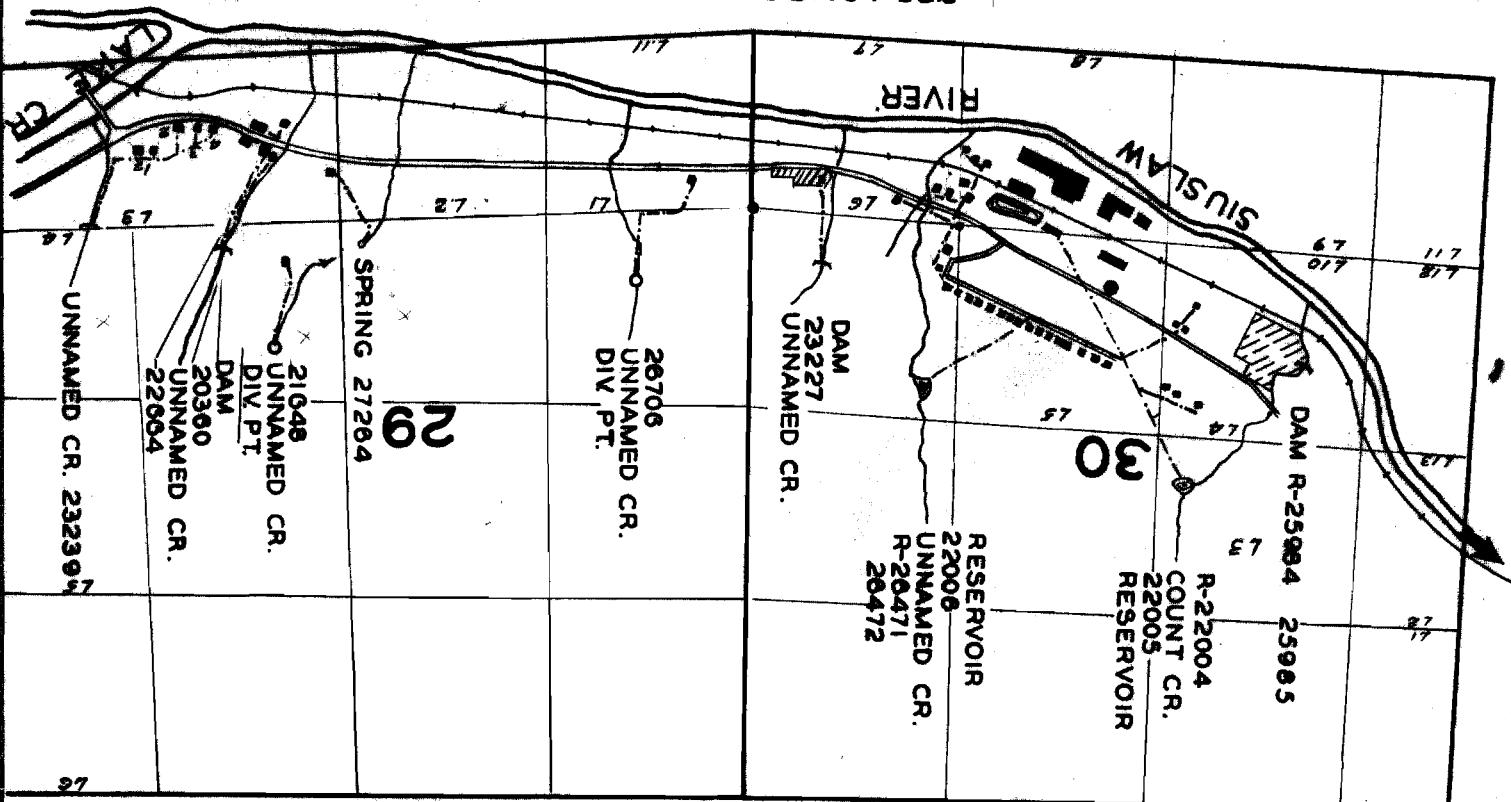

T.175. R.9W.W.M.

C-1

