


19


9
T. 10 S., R. 2 E. WM. LINN, CO. ORE.

MT JEFFERSON LUMBER CO.

Scale 1 in = 100 ft

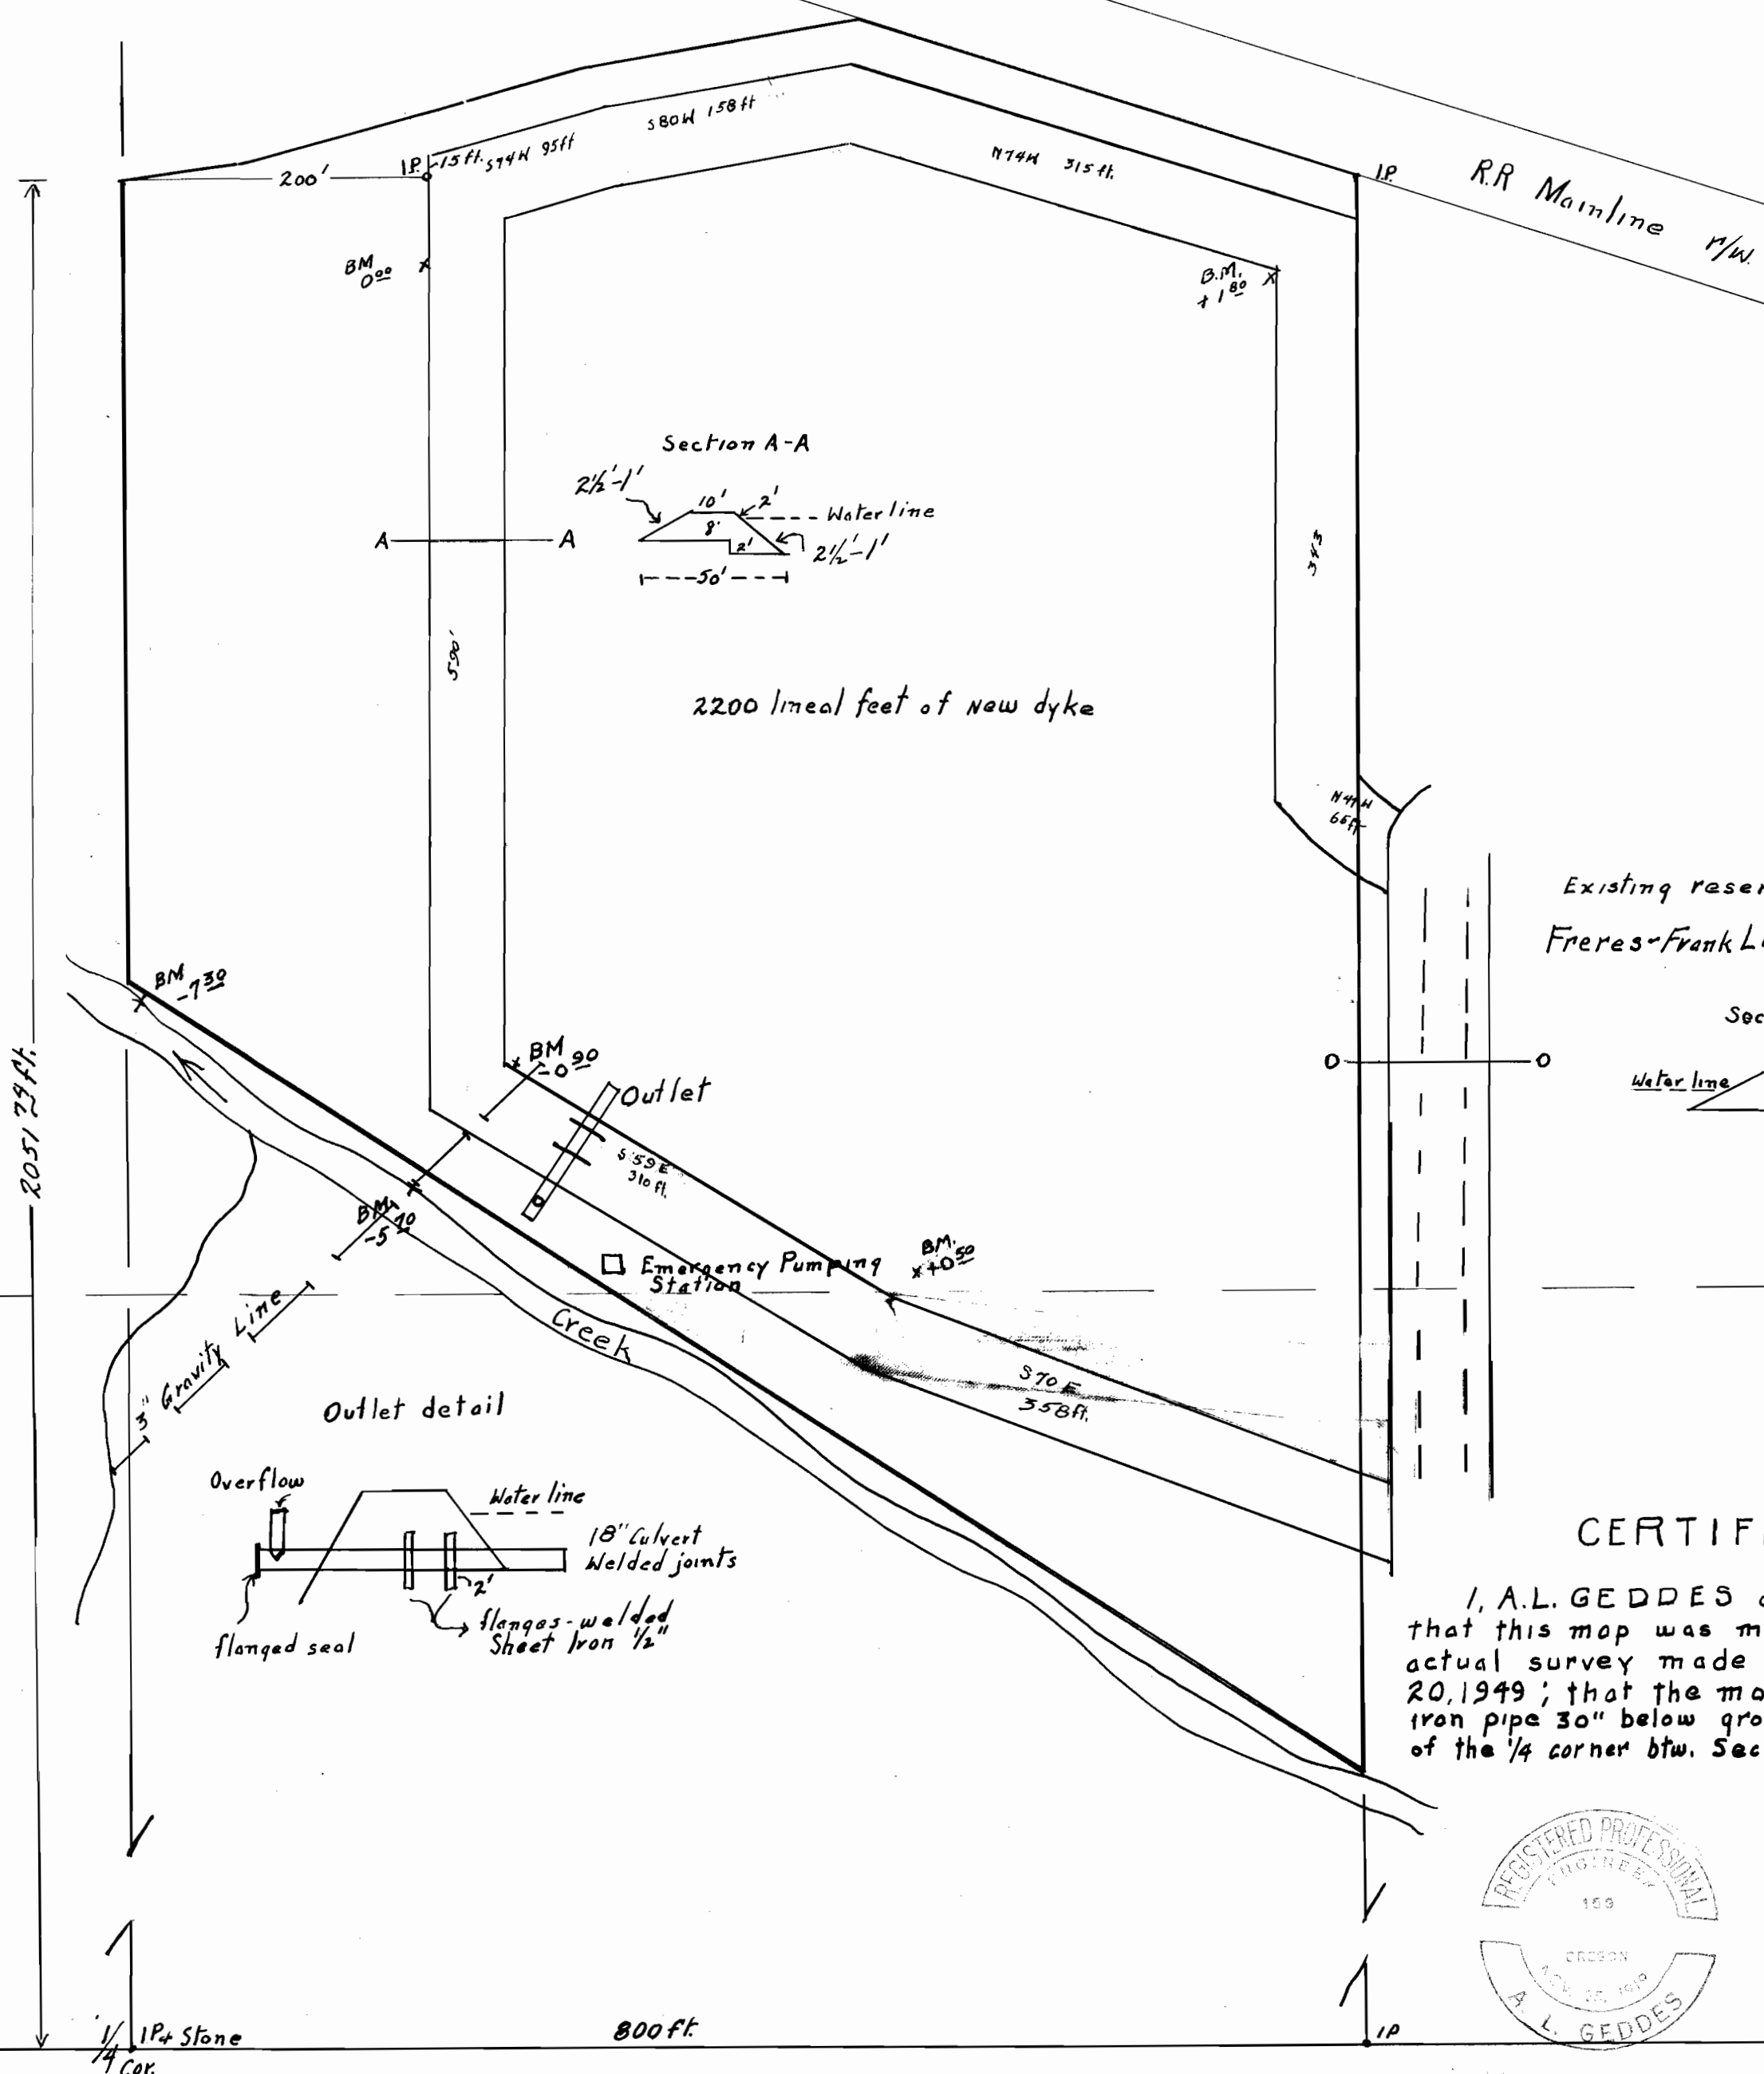

Existing reservoir of
Freres-Frank Lumb. Co.

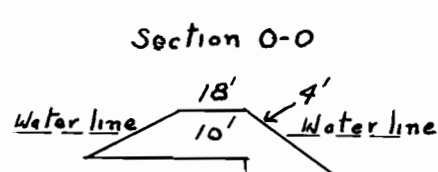

CERTIFICATE of ENGINEER

I, A. L. GEDDES of Lyons Ore. do hereby certify that this map was made from notes taken during an actual survey made under my supervision on September 20, 1949; that the monument shown on the map is a 3ft x 1in iron pipe 30" below ground and is 205124 ft North and 200ft East of the 1/4 corner btw. Sections 19 & 30, T. 10 S., R. 2 E. WM Linn Co. Ore

A. L. Geddes



Application No. R-24146
24147
24148
Permit No. R-999
19111
19112

L. O. S.
9/49