


19


9  
T. 10 S., R. 2 E. WM. LINN CO. ORE.

MT JEFFERSON LUMBER CO.

Scale 1 in = 100 ft

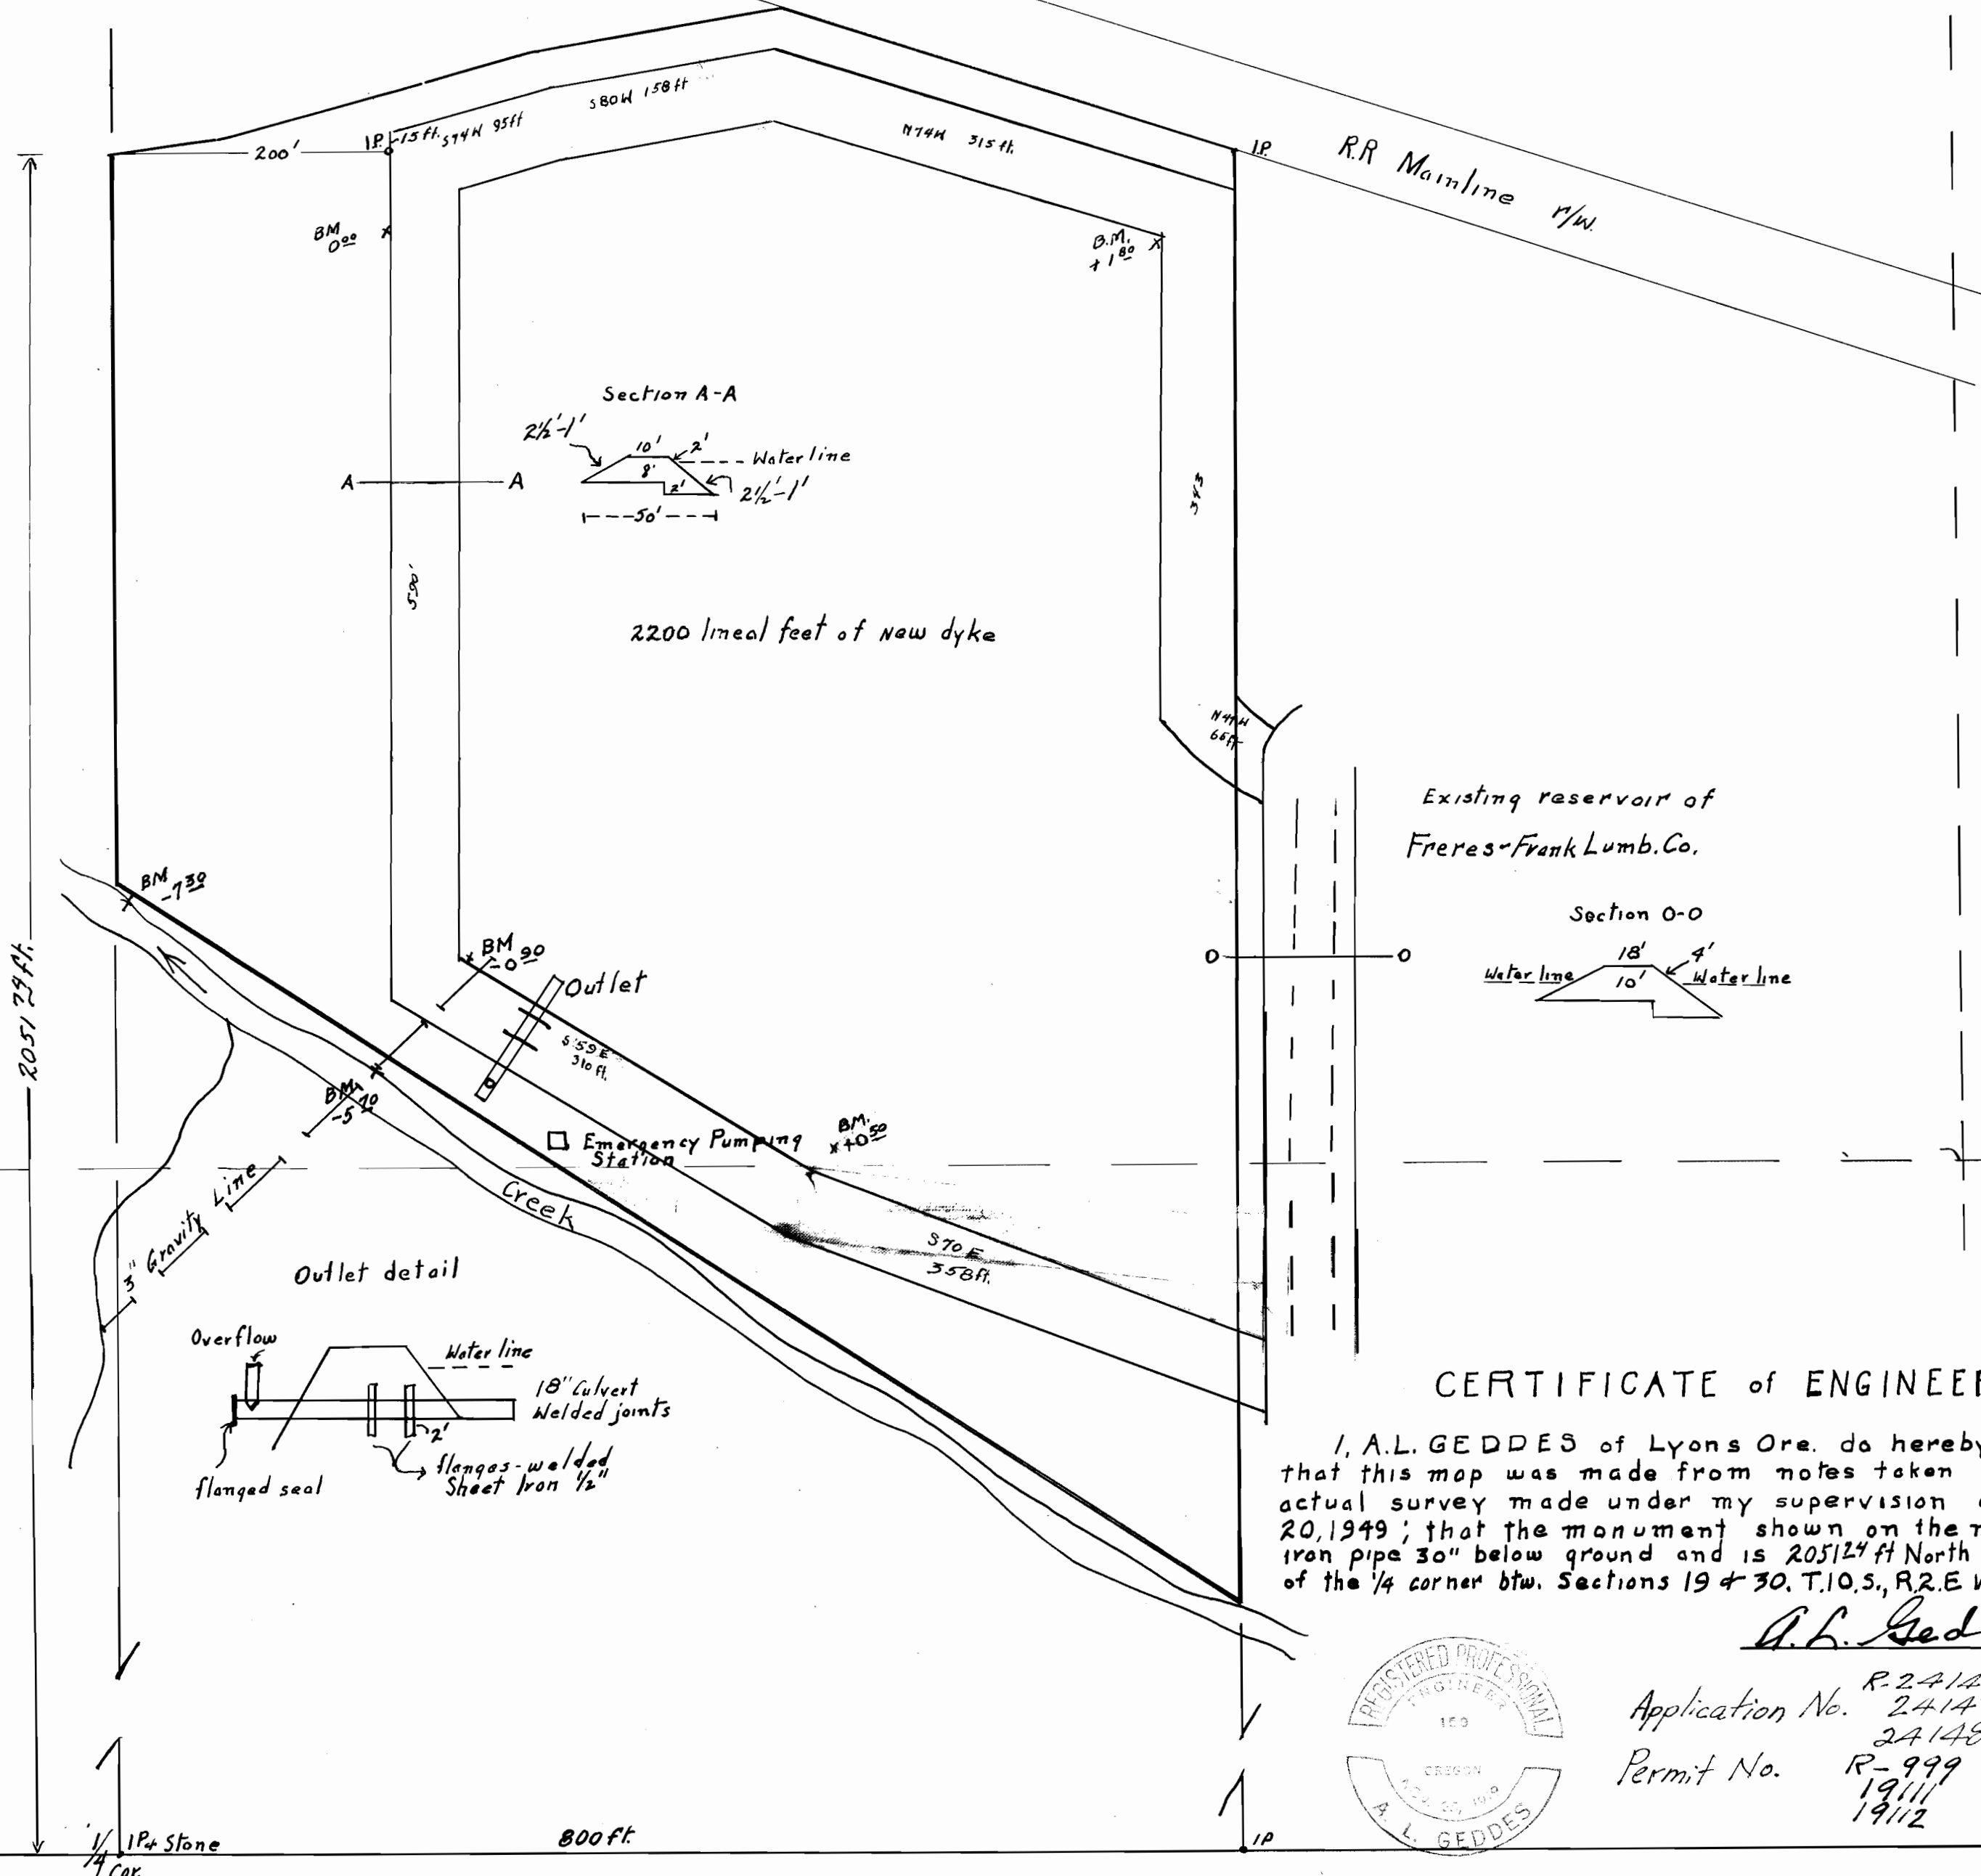

Existing reservoir of  
Freres-Frank Lumb. Co.

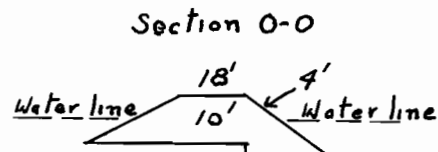

CERTIFICATE of ENGINEER

I, A. L. GEDDES of Lyons Ore. do hereby certify that this map was made from notes taken during an actual survey made under my supervision on September 20, 1949; that the monument shown on the map is a 3ft x 1in iron pipe 30" below ground and is 205124 ft North and 200ft East of the 1/4 corner btw. Sections 19 & 30, T. 10 S., R. 2 E. WM Linn Co. Ore

*A. L. Geddes*



Application No. R-24146  
24147  
24148  
Permit No. R-999  
1911  
1912

L.O.S.  
9/49