


T. 19 & 20 S. R. 1 W. W. M

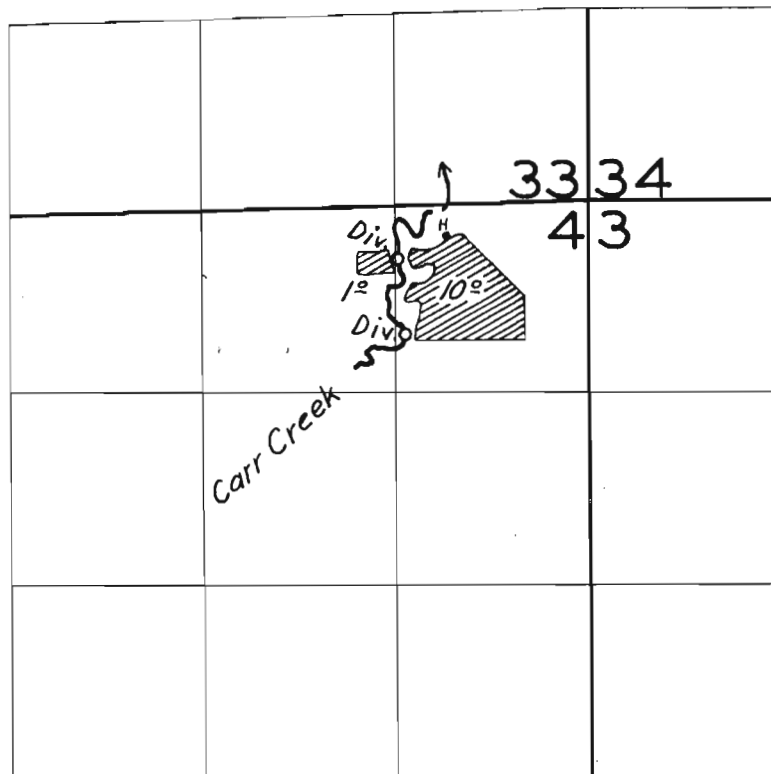

FINAL PROOF SURVEY
UNDER

Application No. 22408 Permit No. 17663
IN NAME OF

Francis E. Henderson

Surveyed May 7 1954, by T. Jones