


T. 1 N., R. 13 E., W.M.

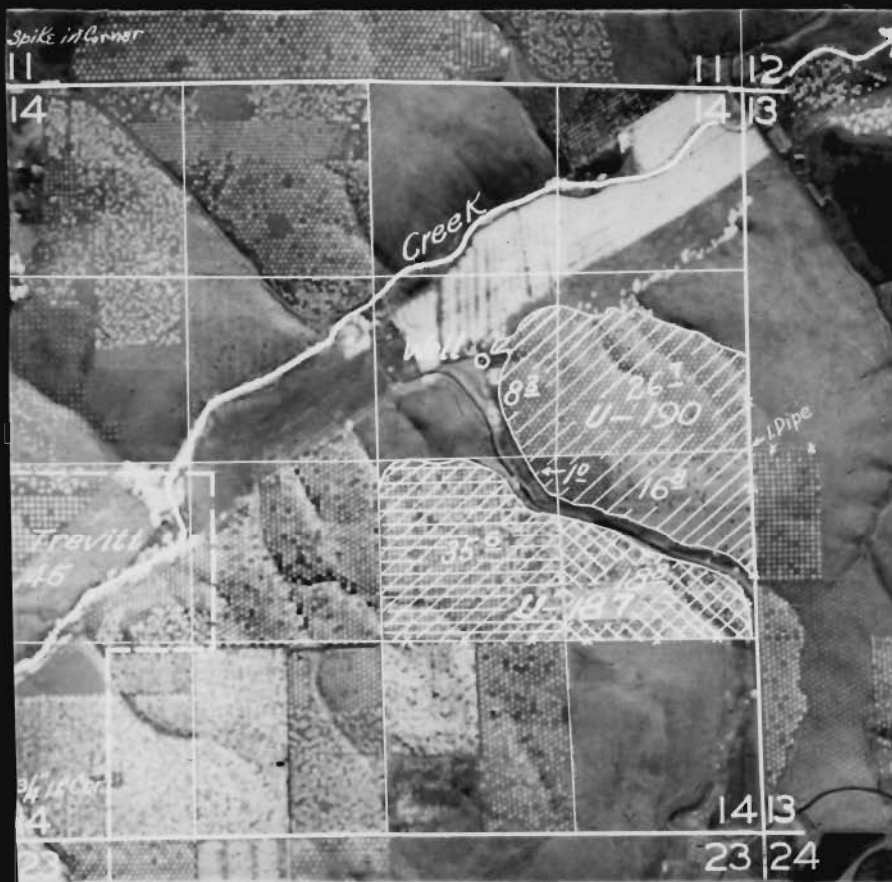

FINAL PROOF SURVEY

UNDER

U-190

U-329

Application No. U-107 Permit No. U-328

IN NAME OF

K. M. W. Irrigation Corporation, Inc.
K. M. W. Irrigation Corporation, Inc.

Surveyed June 9, 1954, by M. L. Goffman.