


V-328
V-329

T. 14 N., R. 13 W.M.

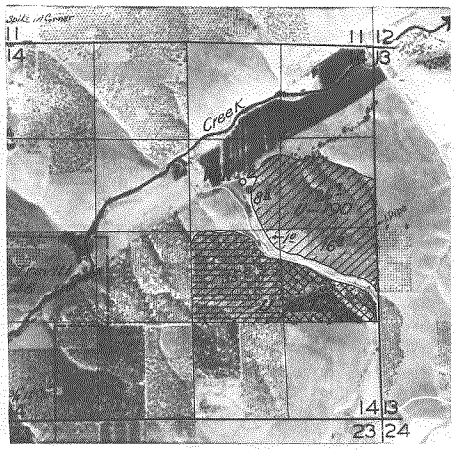

FINAL PROOF SURVEY

UNDER

Application No. 17 Permit No. 17
IN NAME OF

Surveyed 19 by