


T.4 N., R35 E., W.M.

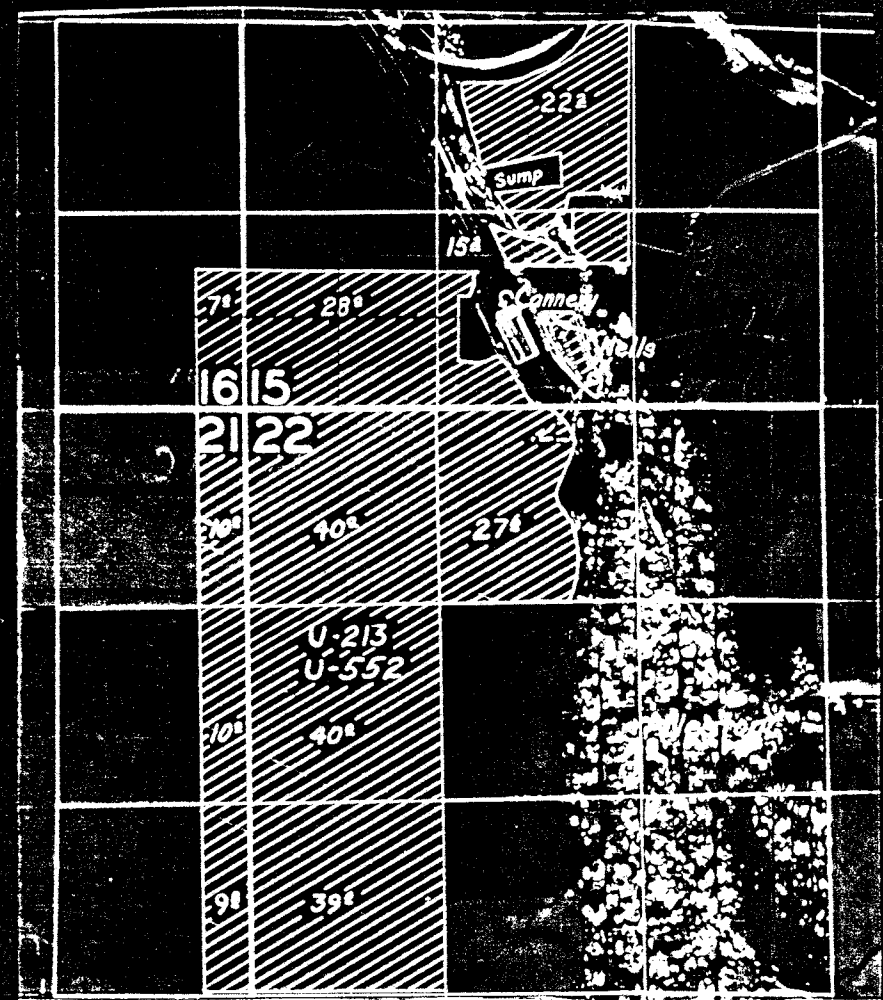

FINAL PROOF SURVEY

UNDER

U-213 U-193

Application No. U-552..... Permit No. U-504....

IN NAME OF

Lamb Weston, Inc.

Surveyed May 18 1954, by T. Jones