


T. 2 N., R. 12 E., W.M.

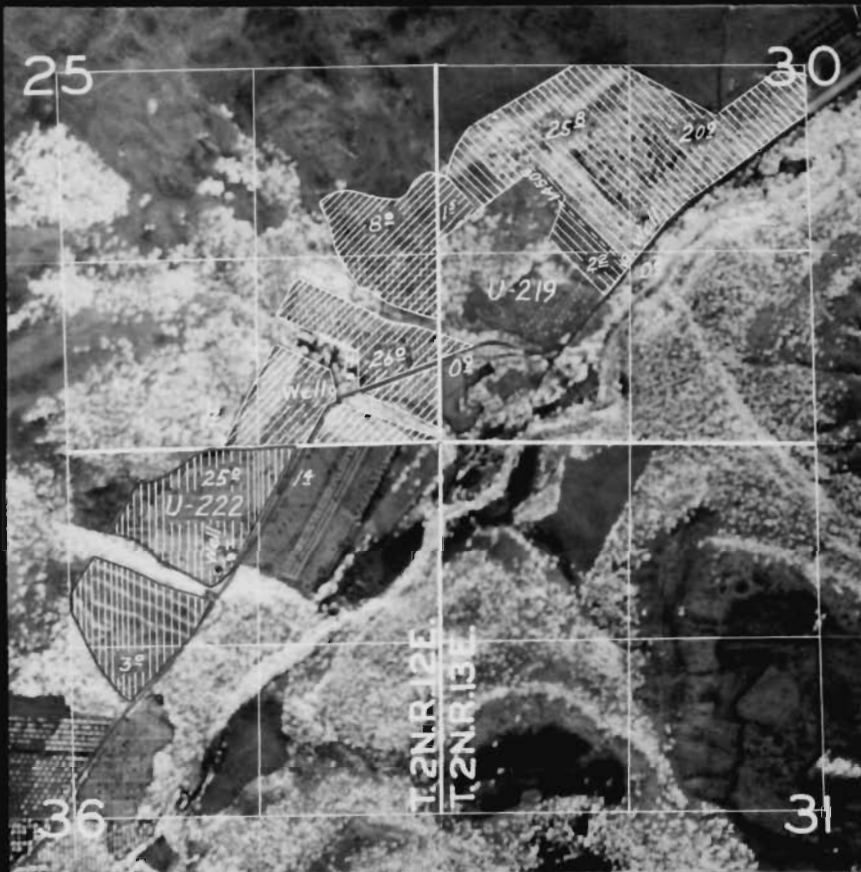

FINAL PROOF SURVEY

UNDER

Application No. U-222 Permit No. U-294
U-219 U-305

IN NAME OF

Henry Larick

Edward L. Weber

Surveyed June 2, 1954, by T. Jones

U-305-68