



U-204
C-20800

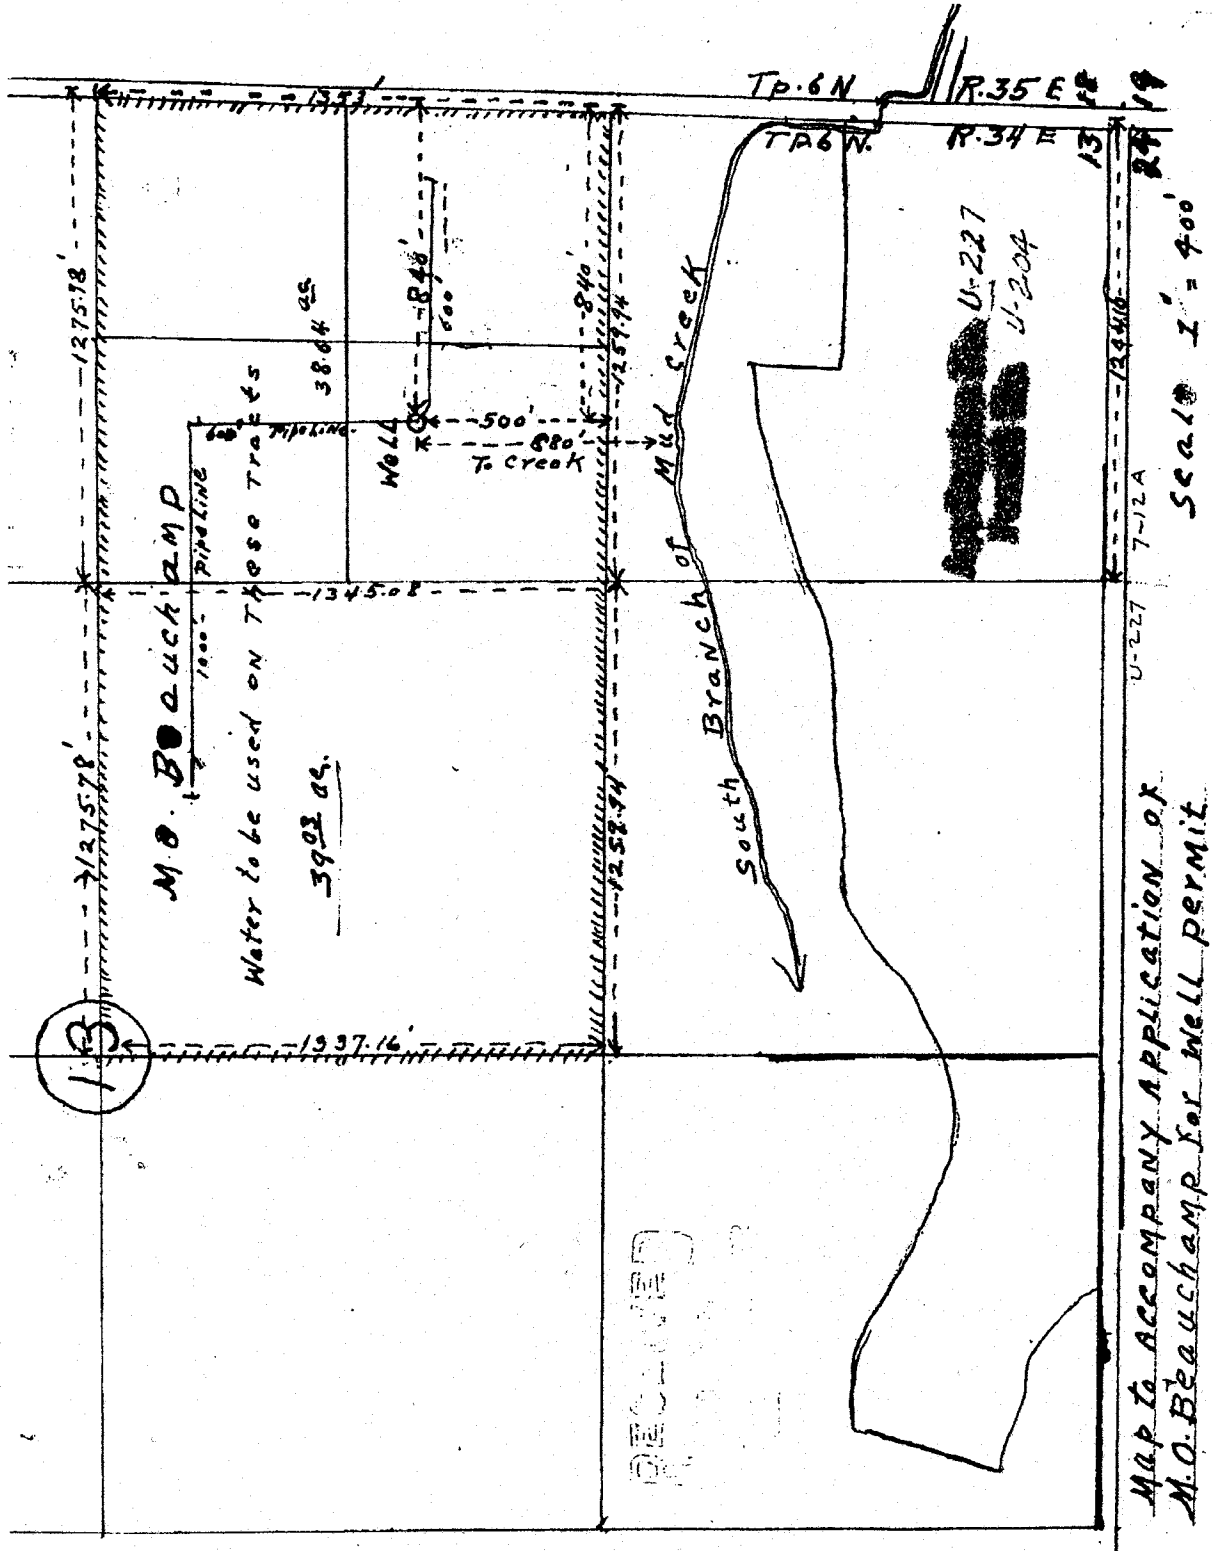

MAP TO ACCOMPANY APPLICATION OF
M.O. BEAUCHAMP FOR WELL PERMIT

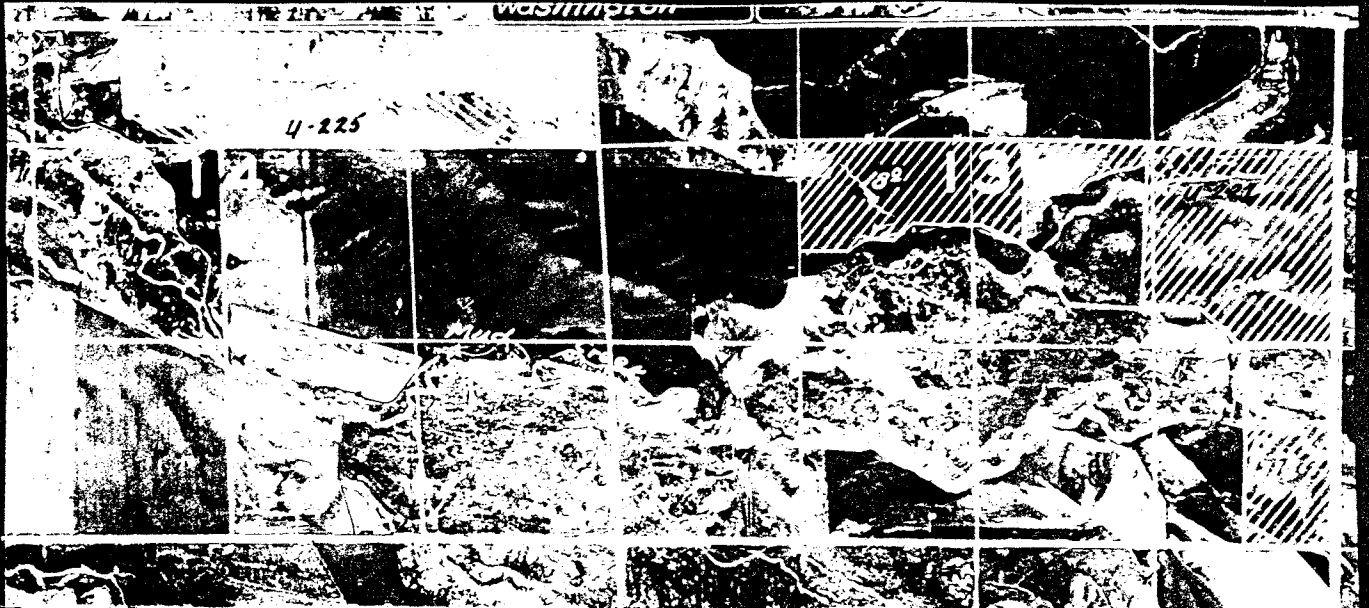

T. 6 N. R. 34 E. WM

FINAL PROOF SURVEY UNDER

M. C. Beauchamp	U-227	U-204
C. J. Hellberg	U-225	U-203
Pete Kessler	U-406	U-376
Frank Patton	U-503	U-458

Surveyed May 17-18, 1954 by

H. L. Coffman

NZ-5F-108

