


T. 5N. R. 28E. WM

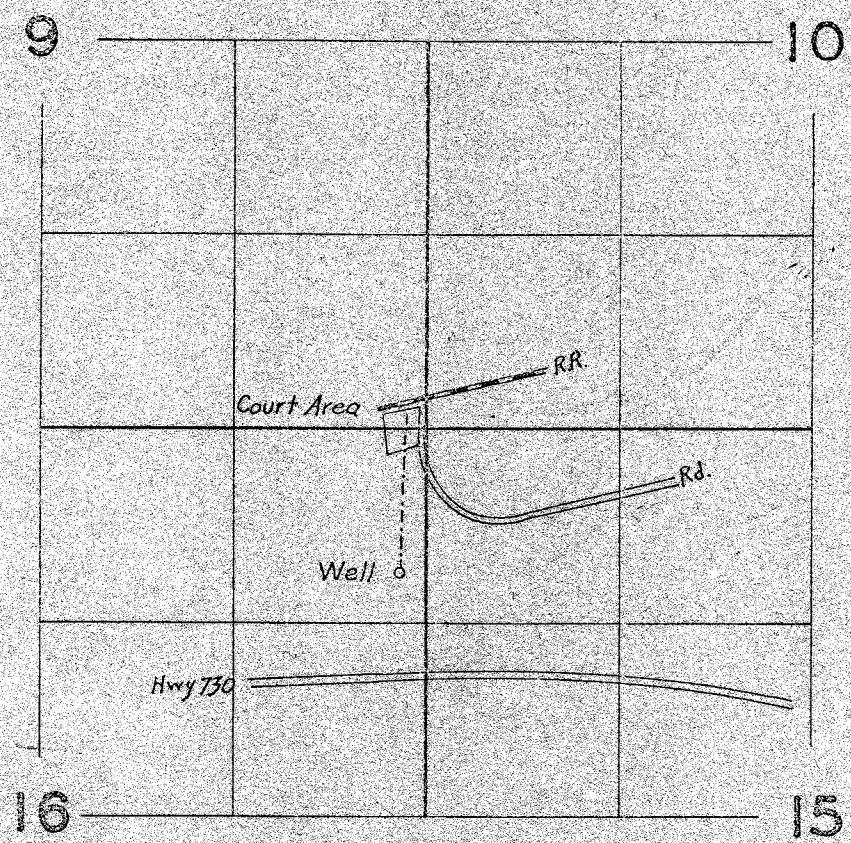

FINAL PROOF SURVEY UNDER

Application No. U-313 Permit No. U-287
IN NAME OF

Ben Shepler

Surveyed May 12, 1951, by T. Jones