
## T. 1 N., R. 13 E., W.M.

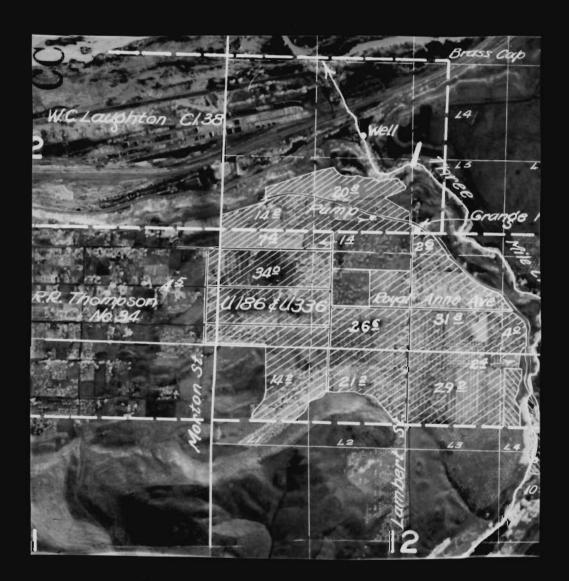

## FINAL PROOF SURVEY

UNDER

J**–**336

J\_321

Application No. U-186 Permit No. U-175 IN NAME OF

Three Mile Irrigation Cooperative Inc.

Surveyed June 11 19 54, by H. L. Coffman

CJ\_3F\_12