


T.5N.35E.W.M.

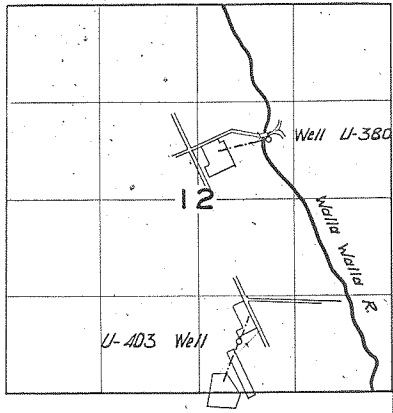

FINAL PROOF SURVEY

UNDER

U-380

U-355

Application No. U-403

Permit No. U-373

IN NAME OF

Rogers Canning Company  
Umatilla Canning Company

Surveyed May 18, 1954, by H. I. Coffman