


T.23 S.R.31 E.W.M.

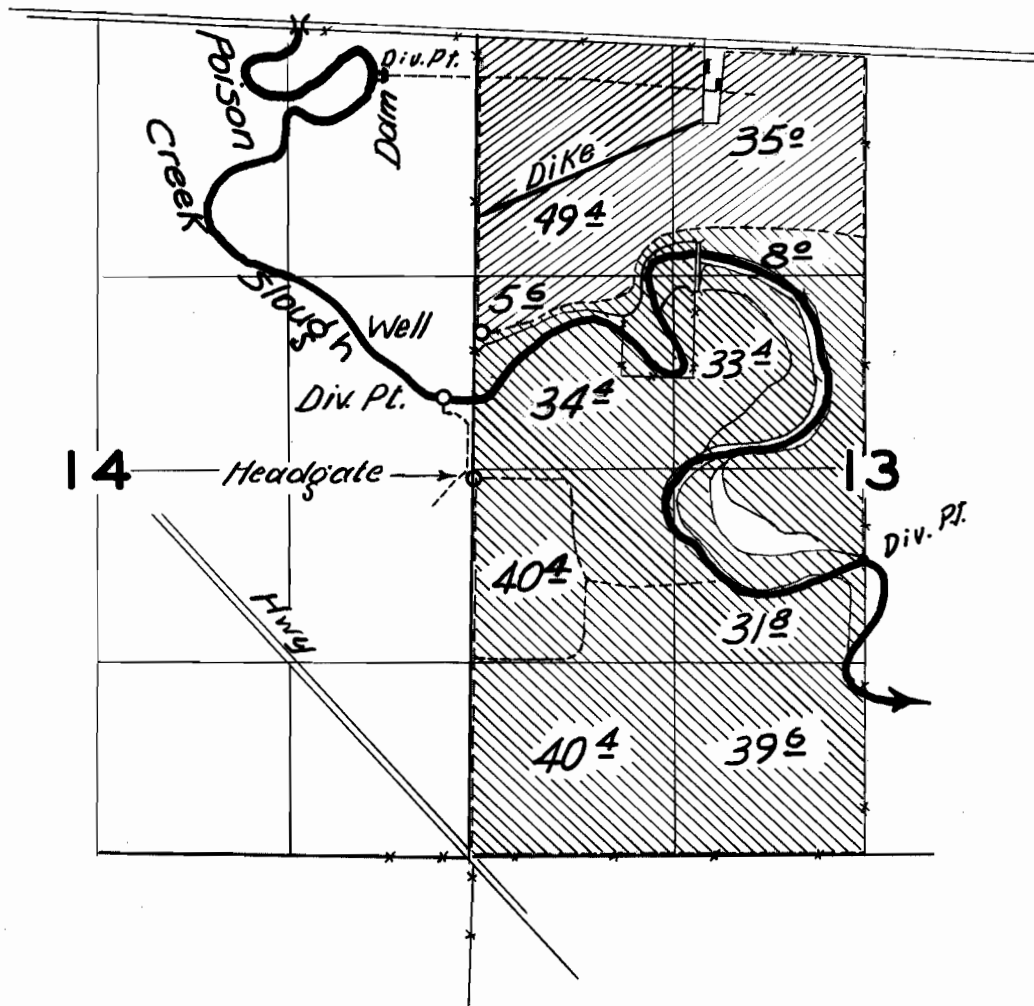

FINAL PROOF SURVEY

UNDER

U-112

U-380

Application No. 25685 Permit No. 20133

IN NAME OF

C. D. Falk

Surveyed June 25, 1951, by H. L. Hoffman