


~~U-466~~ U-467  
U-404 U-467  
 17482, 22200

35  
 T.6N., R.36E., W.M.

C-20850  
 C-20812

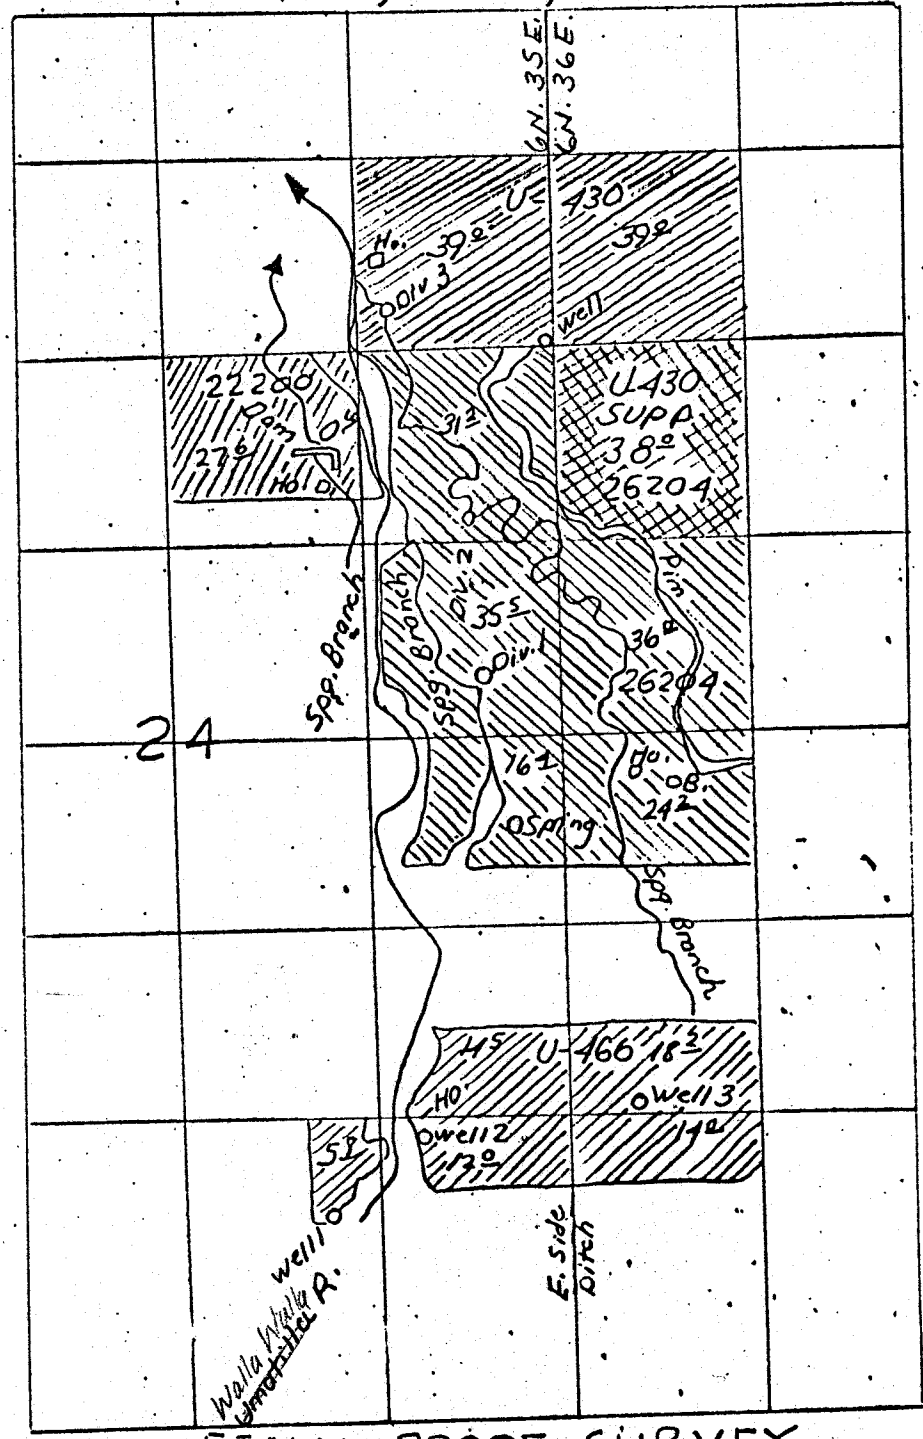

FINAL PROOF SURVEY

veva L. Heidenrich	Appl. No. U-466	Per. No. U-467
D. D. Nicholas	26204	20437
O. D. Nicholas	U-430	U-404
R. K. + G. K. Walter	22200	17482

copied in State Engineer's Office