


U-426

C-20813

# T.6N.R.35E.W.M.

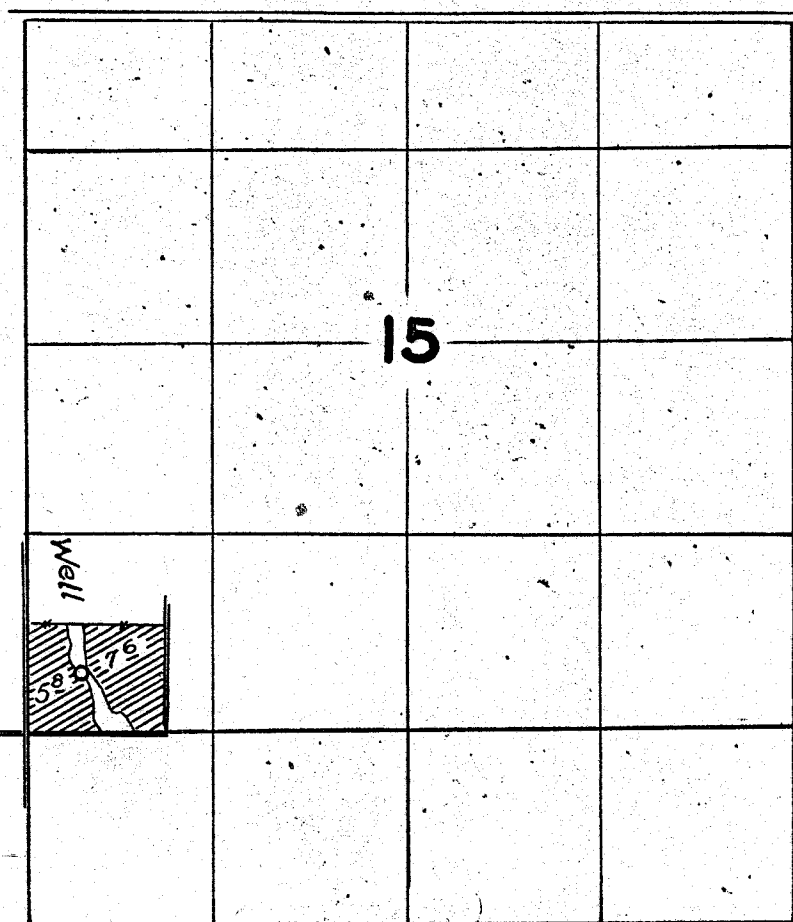

## FINAL PROOF SURVEY UNDER

Application No. U-470 Permit No. U-426

IN NAME OF

A. D. Wilkowske

Surveyed May 14 1954, by H. L. Coffman

NZ-5F-104