


T.3 N., R.29 E., W.M.

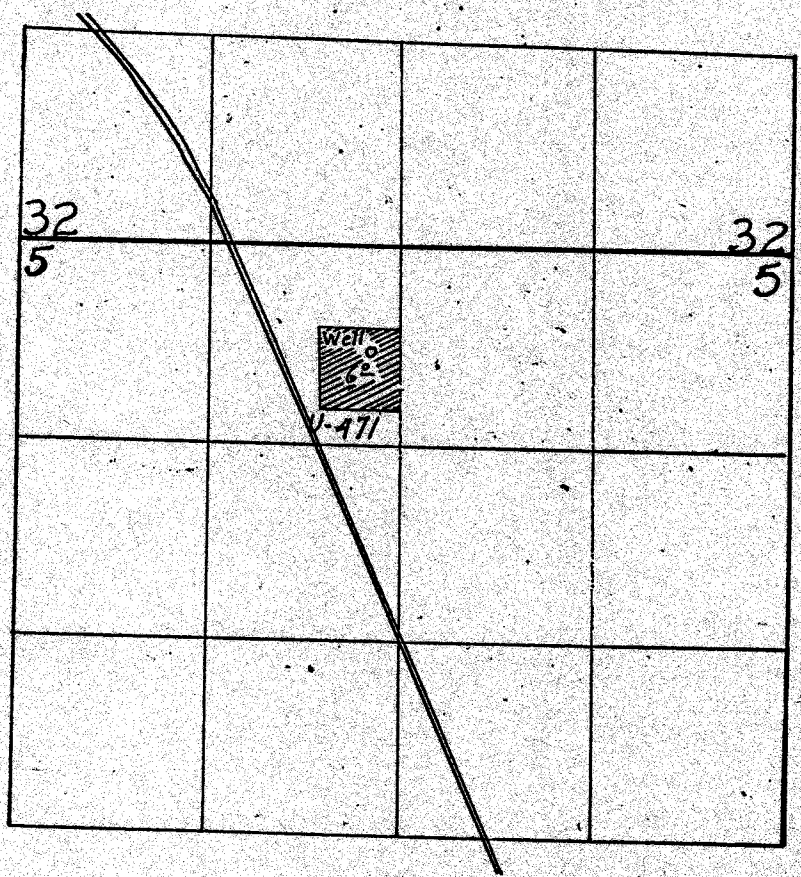

Application No. U-471 Permit No. U-427