


C-20817 U-504

T.4 N., R35 E., W.M.

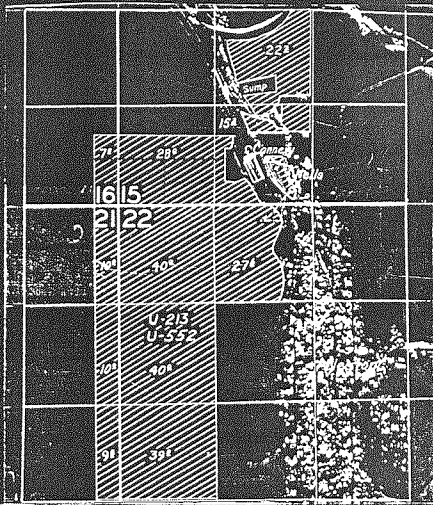

FINAL PROOF SURVEY

UNDER

U- 213

U-193

Application No. U-552..... Permit No. U-504.....
IN NAME OF

Lamb Weston, Inc.

Surveyed May 18, 1954, by T. Jones

112-31-90