


T.5&6S.R.7E.WM

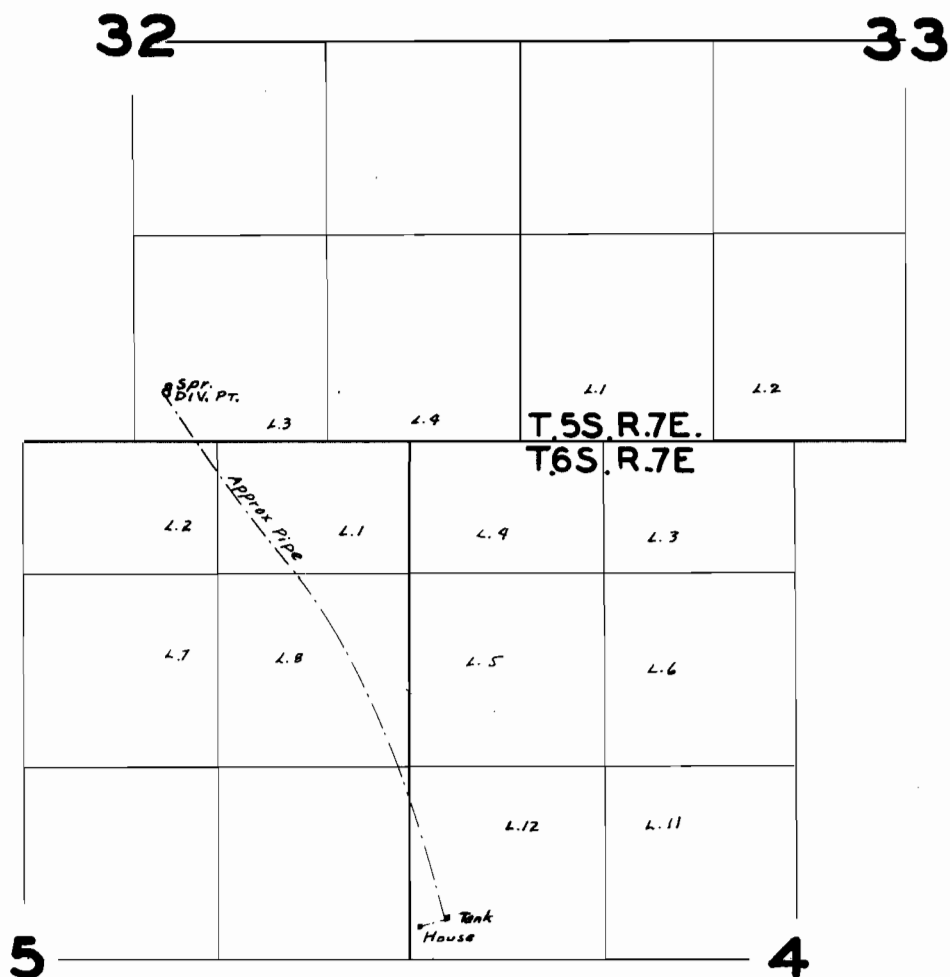

FINAL PROOF SURVEY

UNDER

Application No. 14593 Permit No. 10603

IN NAME OF

PORTLAND GENERAL ELECTRIC CO.

Surveyed Aug. 6 1953, by T. Jones