


T.IOS,R.IW.WM

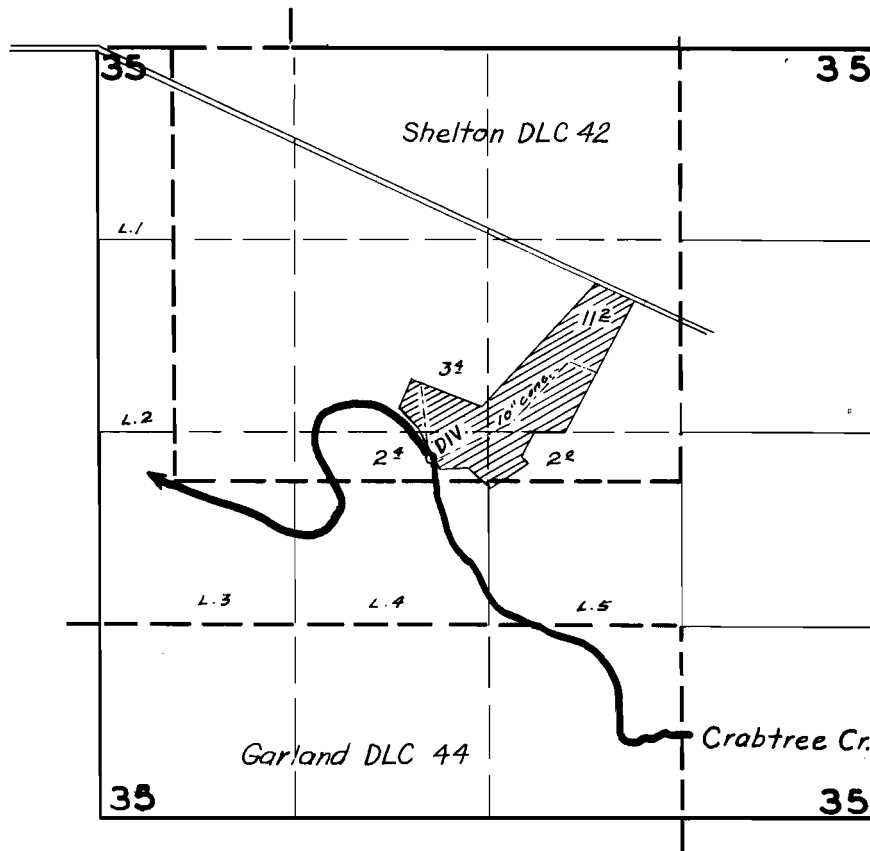

FINAL PROOF SURVEY UNDER

Application No. 16406... Permit No. 12203...
IN NAME OF

..... Geo. Marcus Krause

Surveyed July 13, 1954, by H. L. Goffman.