


T. 7S. R. 3W. WM

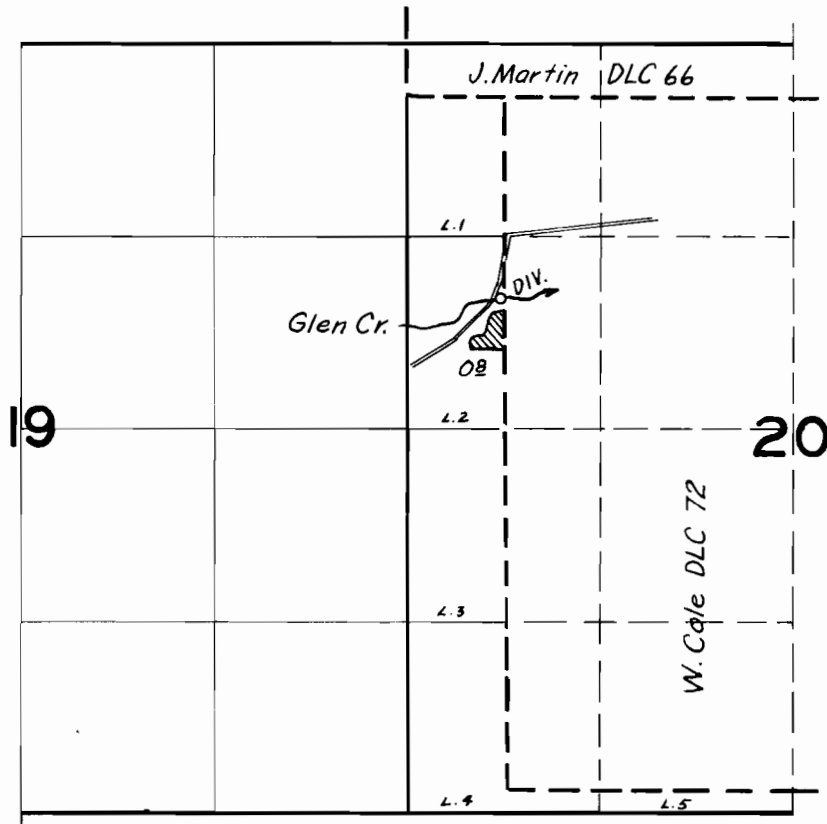

FINAL PROOF SURVEY

UNDER

Application No. 1111 Permit No. 1011

IN NAME OF

.....

Surveyed August 19, 19, by Jones