


T.I.S.R. I.W.WM

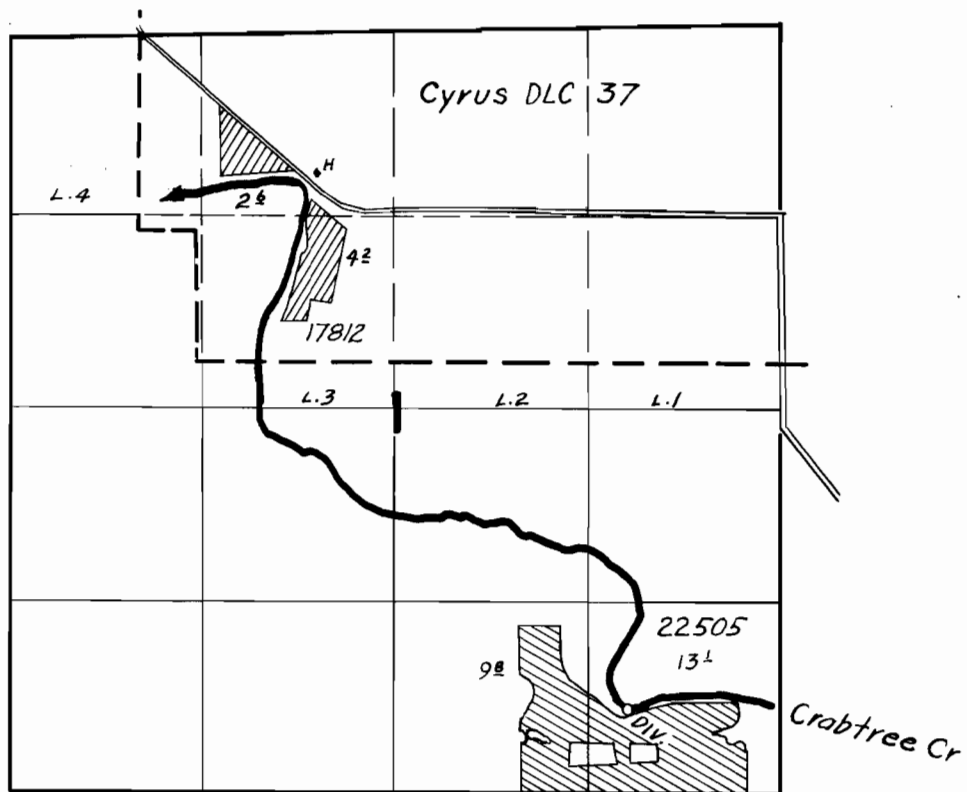

FINAL PROOF SURVEY

UNDER

17812

13486

Application No. 22505

Permit No. 17738

IN NAME OF

Ed Stepanek

L. E. Slawter

16

Surveyed July 15/ 1954, by H. L. Coffman