


T.3S.R. 11 & 12E.W.M.

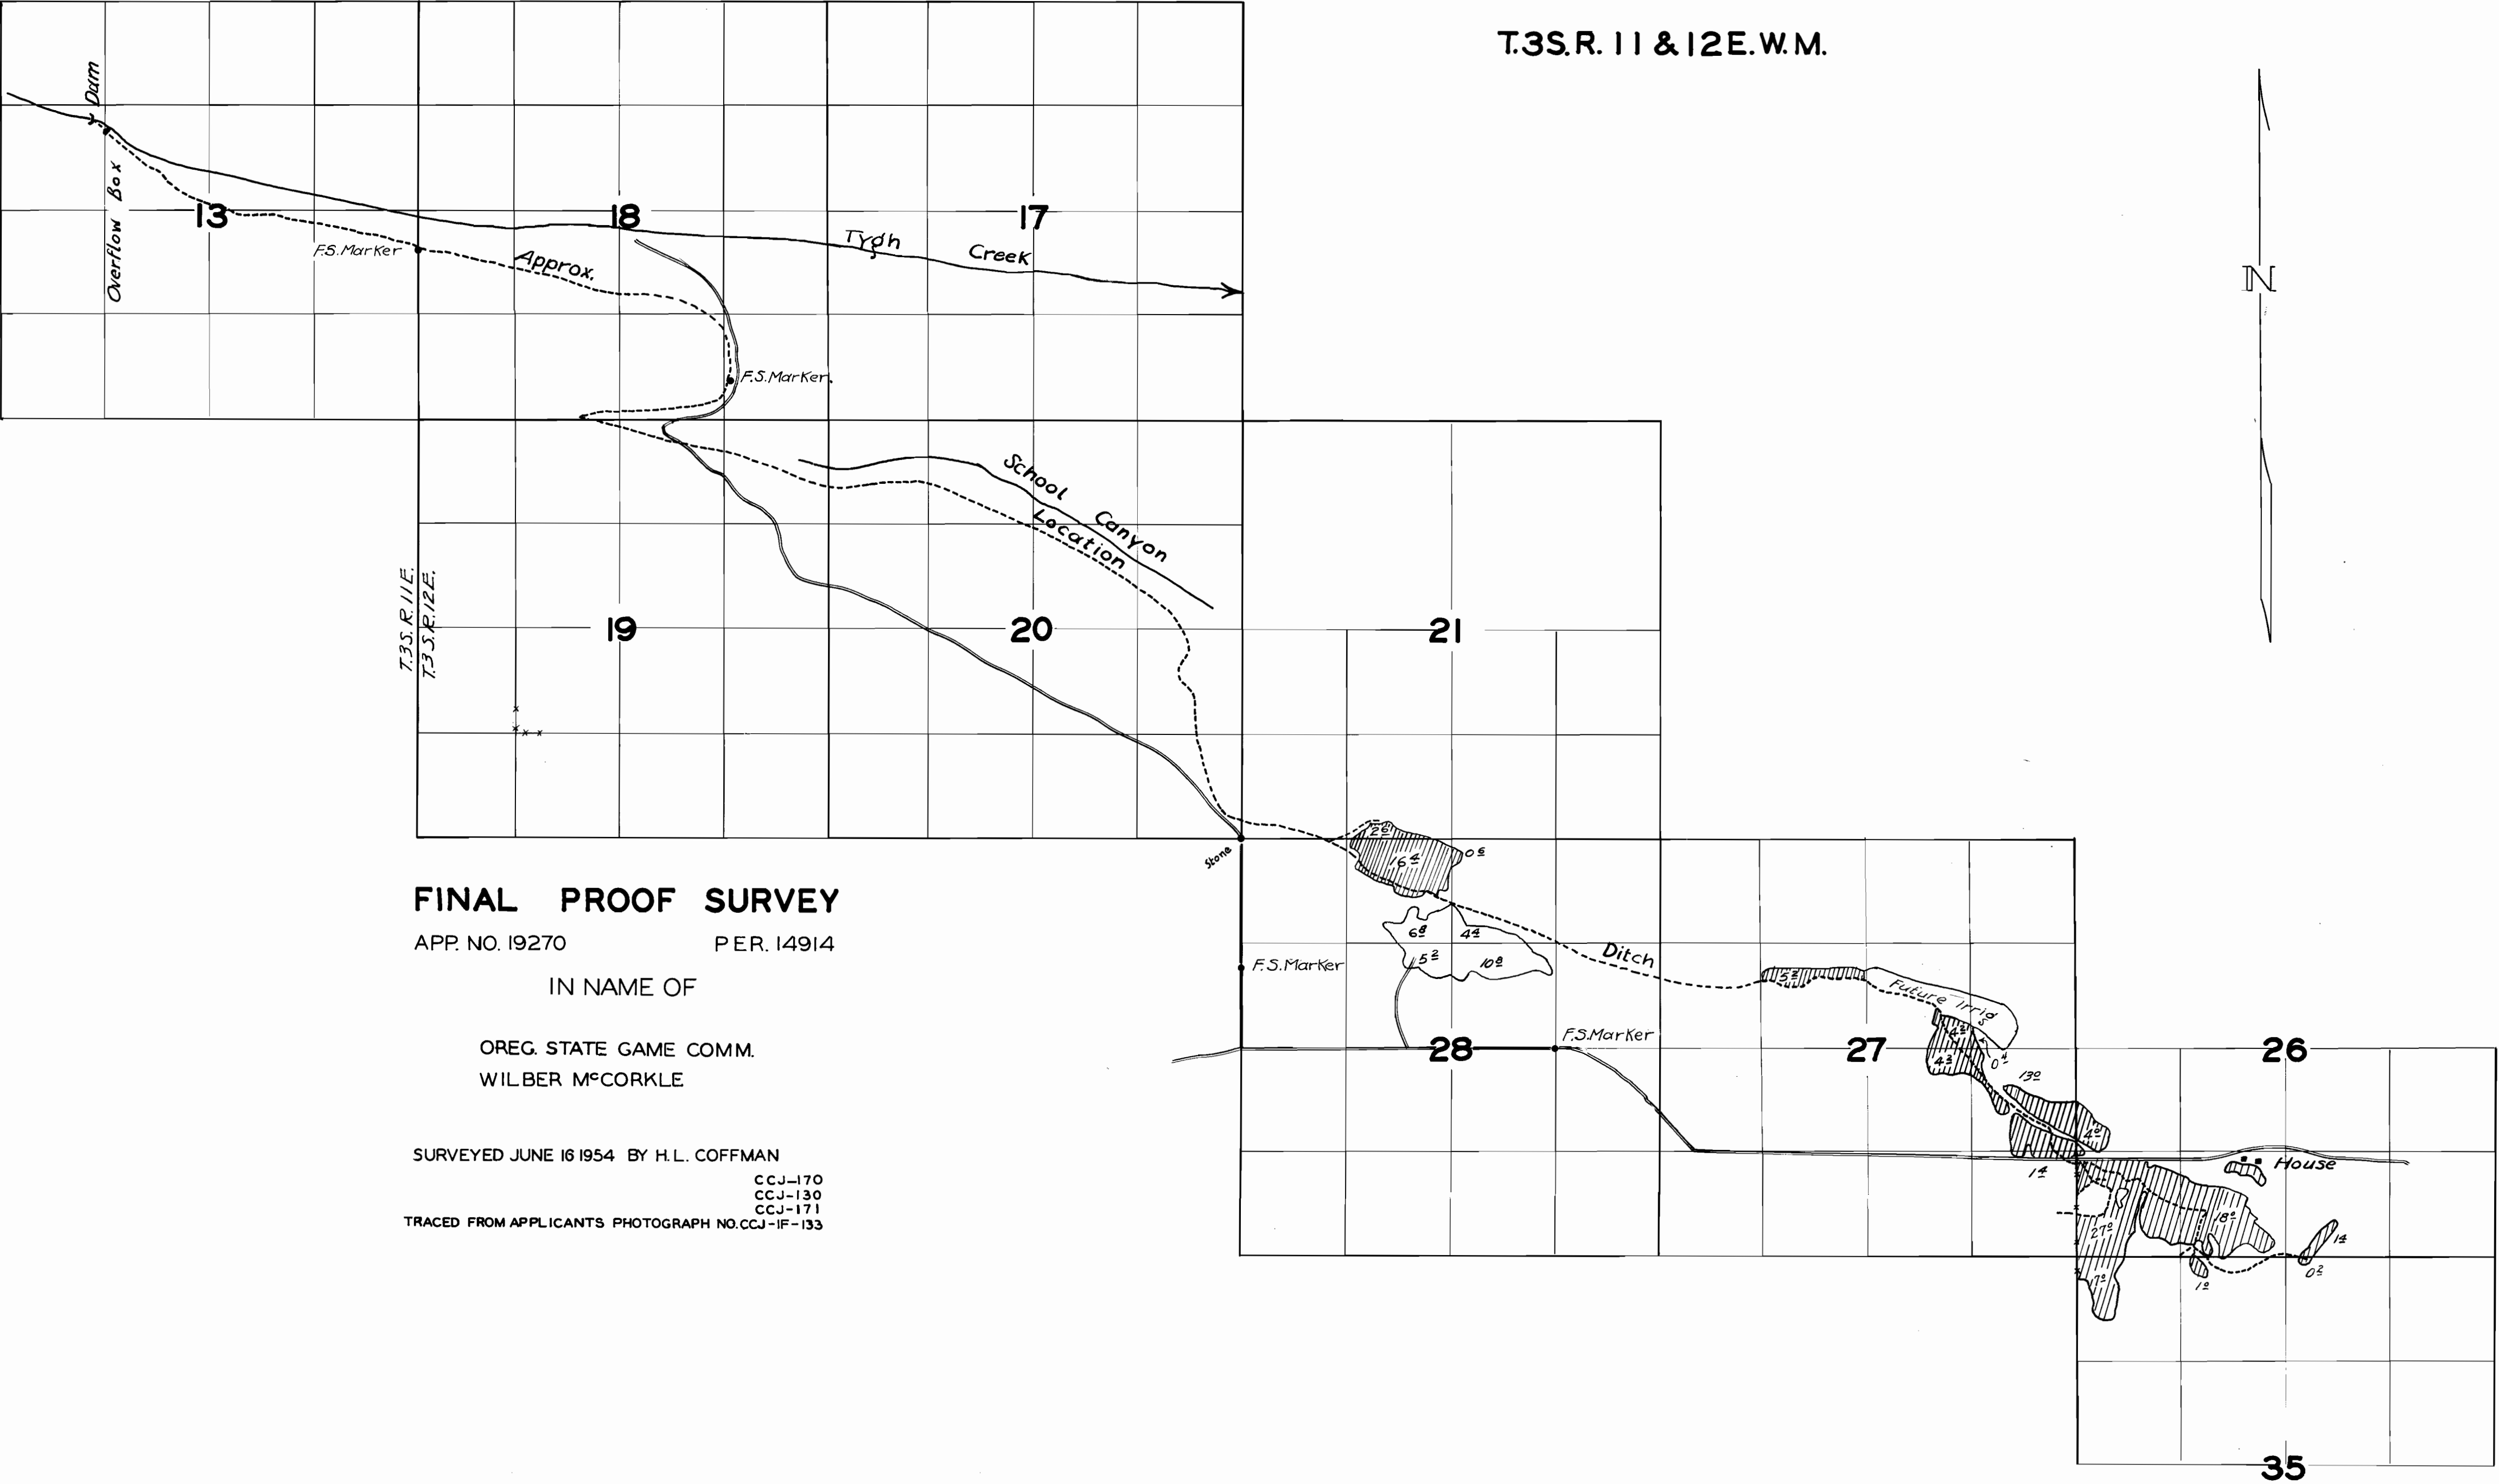

T.3S.R. 11E.  
T.3S.R. 12E.

**FINAL PROOF SURVEY**

APP. NO. 19270      P.E.R. 14914

IN NAME OF

OREG. STATE GAME COMM.  
WILBER M<sup>c</sup>CORKLE

SURVEYED JUNE 16 1954 BY H. L. COFFMAN  
CCJ-170  
CCJ-130  
CCJ-171  
TRACED FROM APPLICANTS PHOTOGRAPH NO. CCJ-IF-133