


T.3S.R. 11 & 12E.W.M.

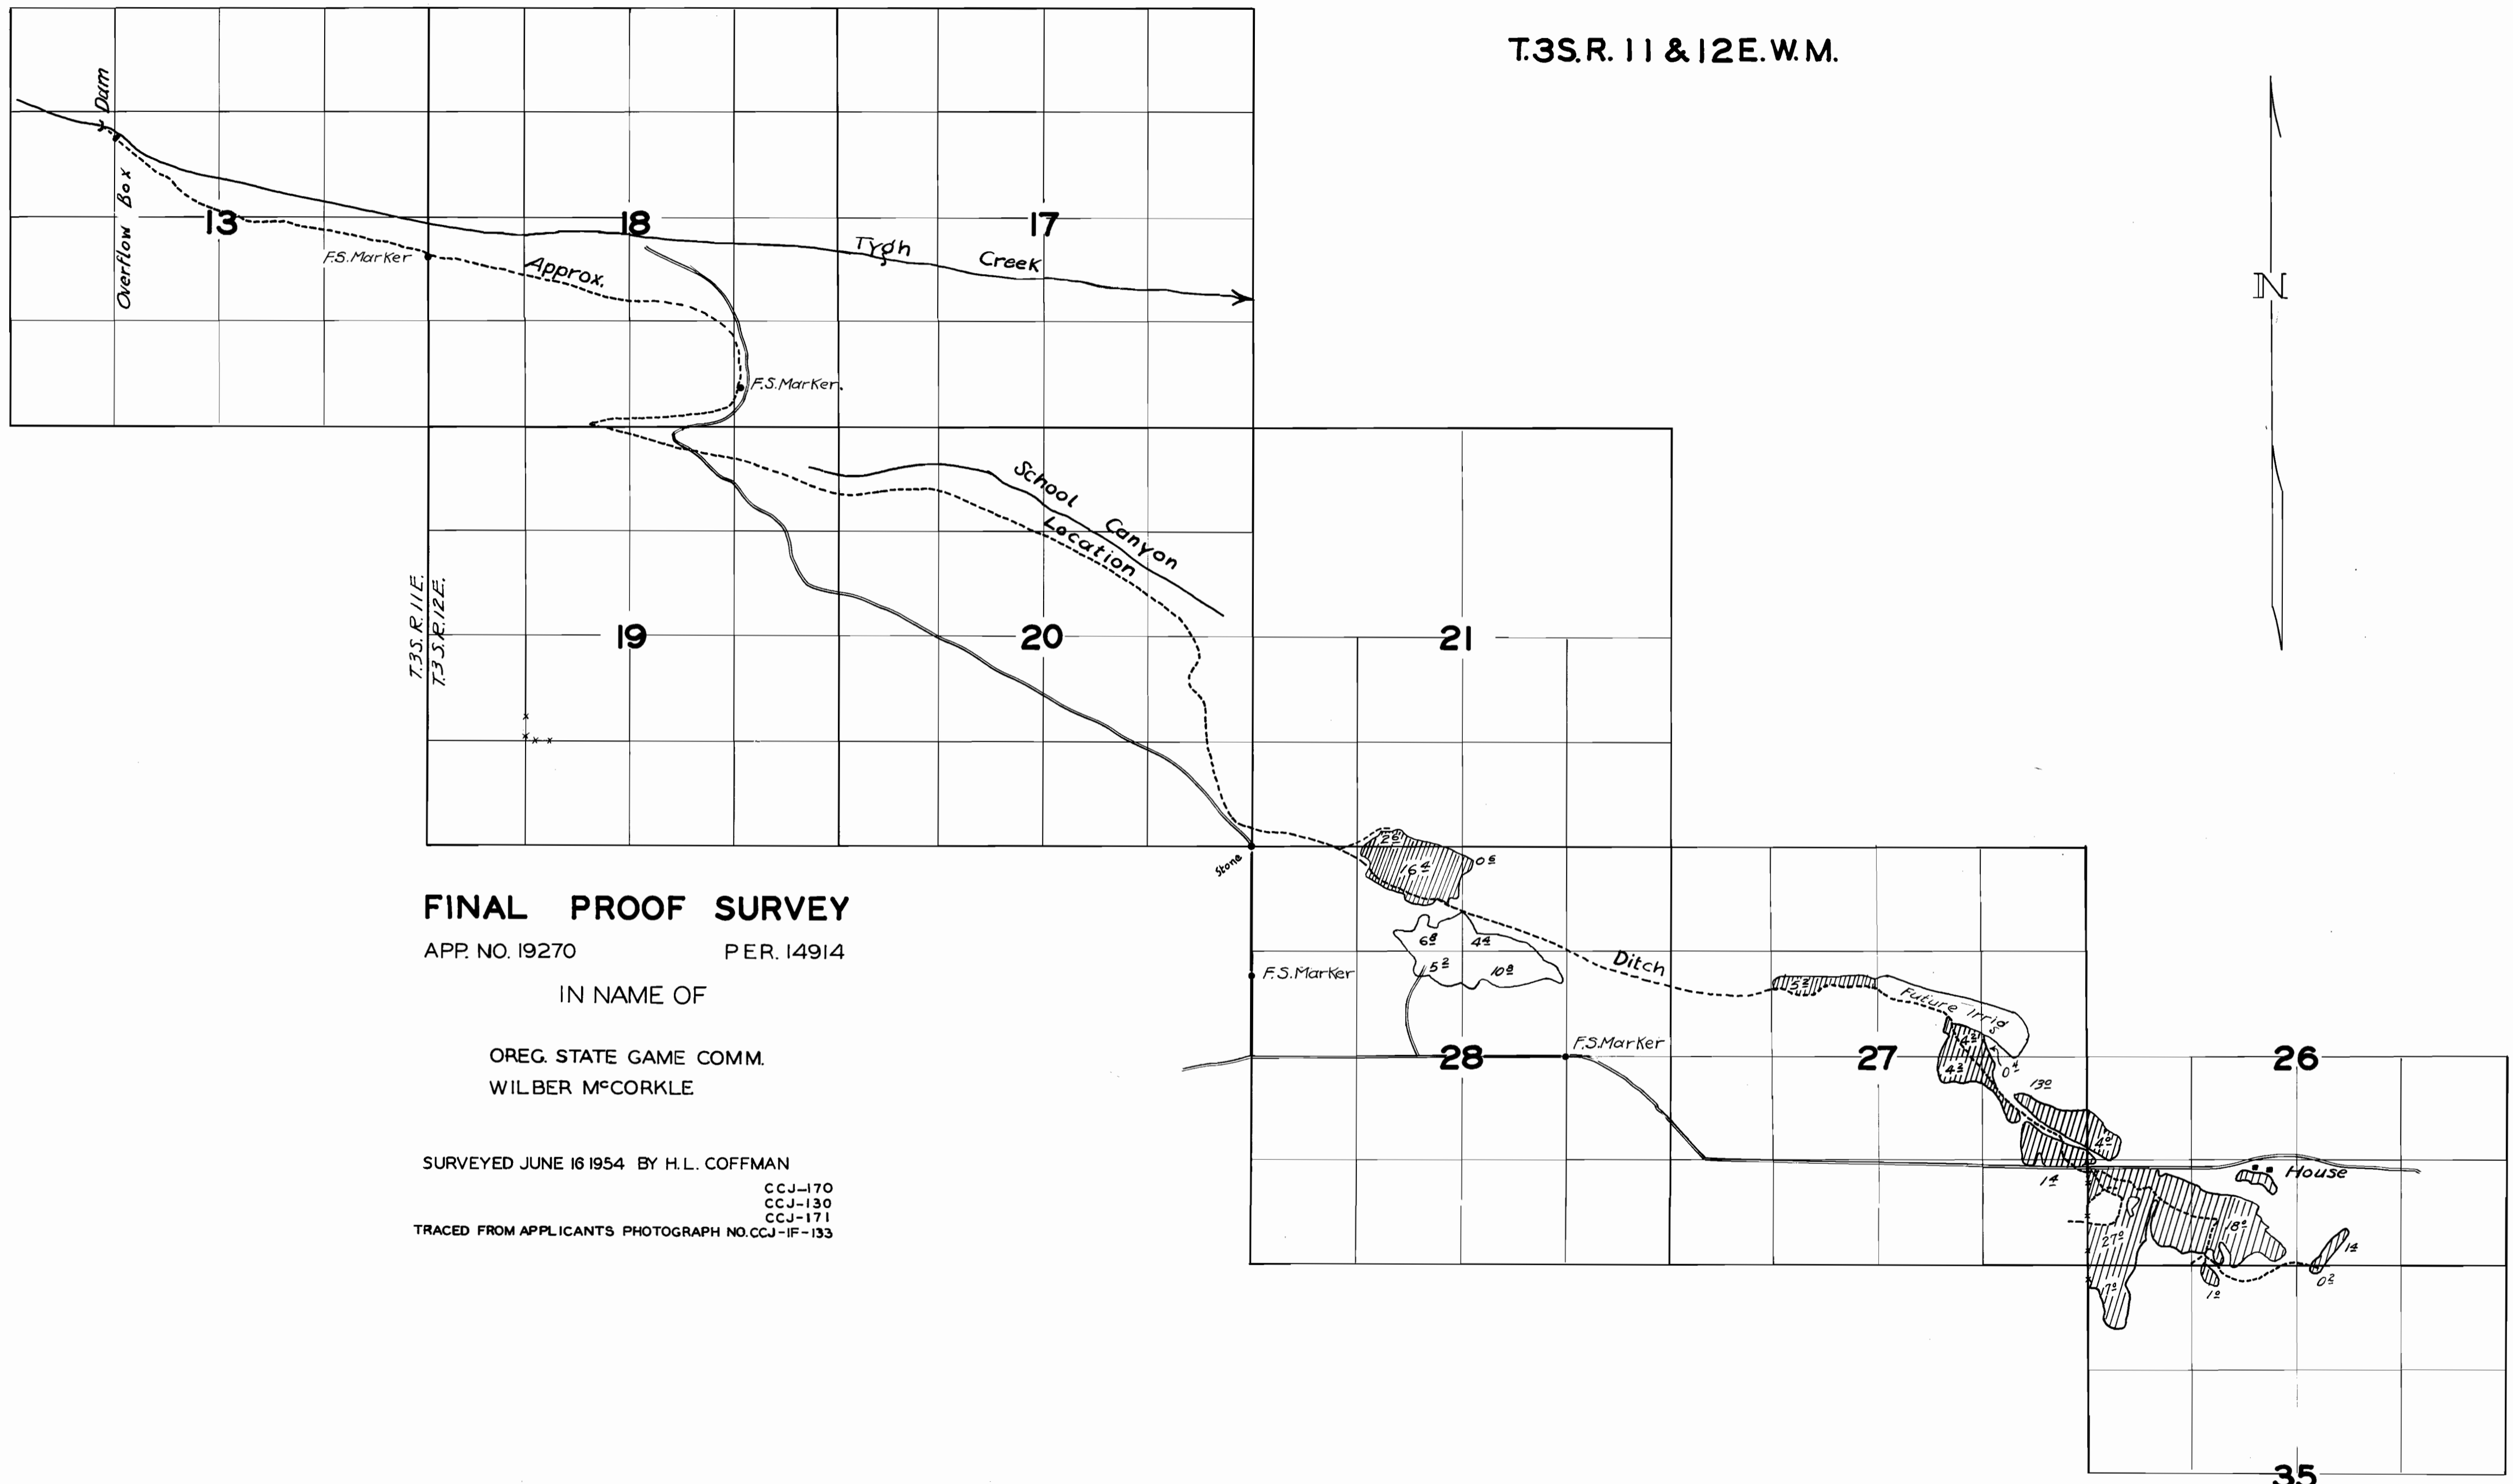

T.3S.R. 11E.
T.3S.R. 12E.

FINAL PROOF SURVEY

APP. NO. 19270 PER. 14914

IN NAME OF

OREG. STATE GAME COMM.
WILBER M^CCORKLE

SURVEYED JUNE 16 1954 BY H.L. COFFMAN
CCJ-170
CCJ-130
CCJ-171
TRACED FROM APPLICANTS PHOTOGRAPH NO. CCJ-IF-133