


T.5N.R.35 E.W.M.

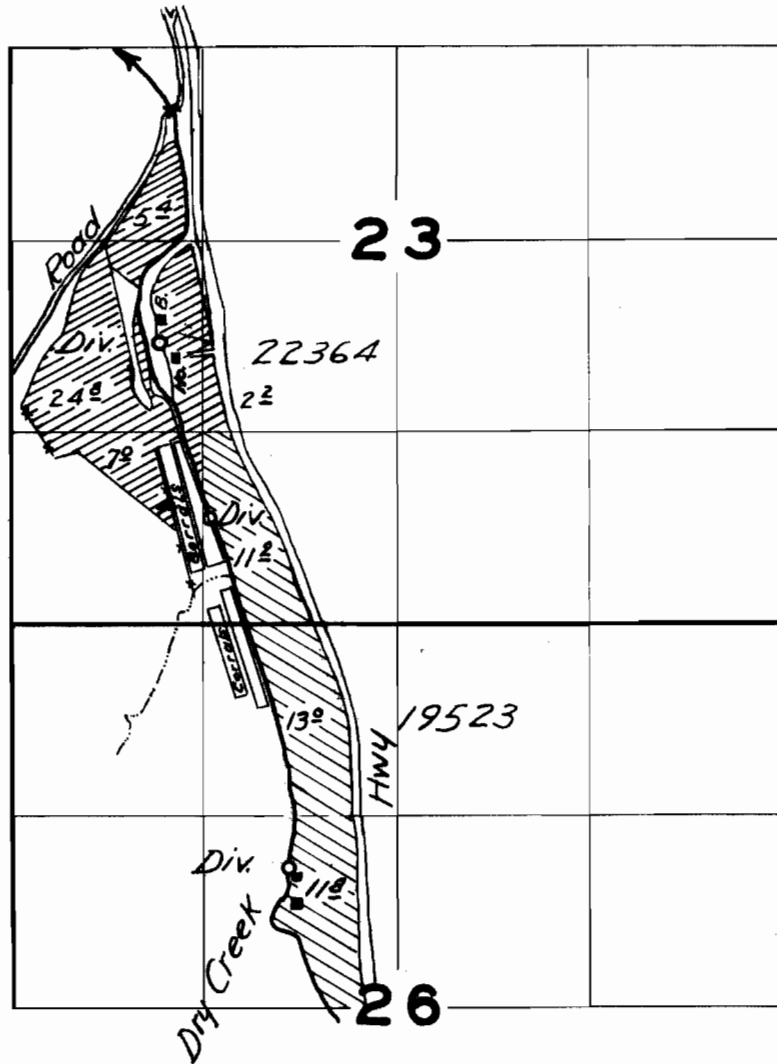

FINAL PROOF SURVEY

UNDER

Application No. 19523 2364 Permit No. 15114 17366

IN NAME OF

Wm. H. Steen
Wm. H. Steen, W. Lowell Steen, Eva Steen Shannon

Surveyed May 19, 1954, by W. L. Coffman

NZ-4F-146
NZ-4F-47