T.5N.R.35 E.W.M.

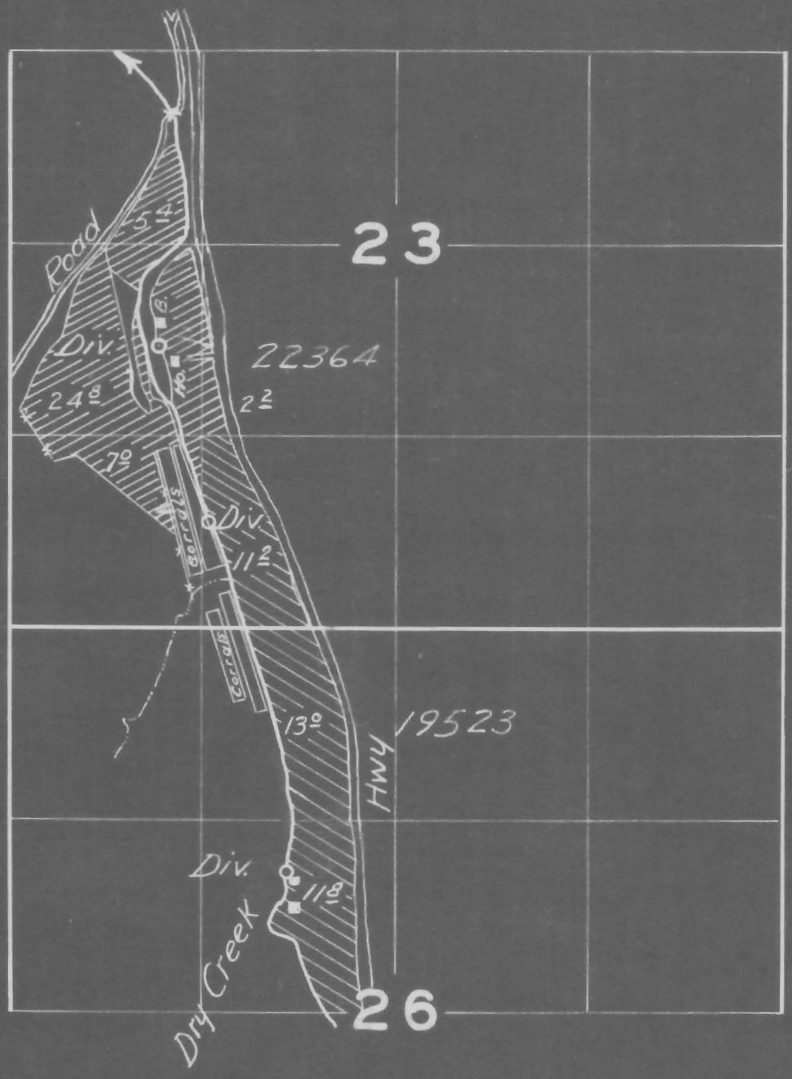

FINAL PROOF SURVEY

UNDER

Application No. 19523 23611 Permit No. 15114 17386

IN NAME OF

Wm. H. Steen

Wm. H. Steen, W. Lowell Steen, Eva Steen Shannon

Surveyed May 19 19 54, by H. L. Coffman.

NZ-4F-146
NZ-4F-47